



San Pablo 11-4 WD
Lot 4 - San Pablo Canyon Ranches
Sec 4, T33S, R67W

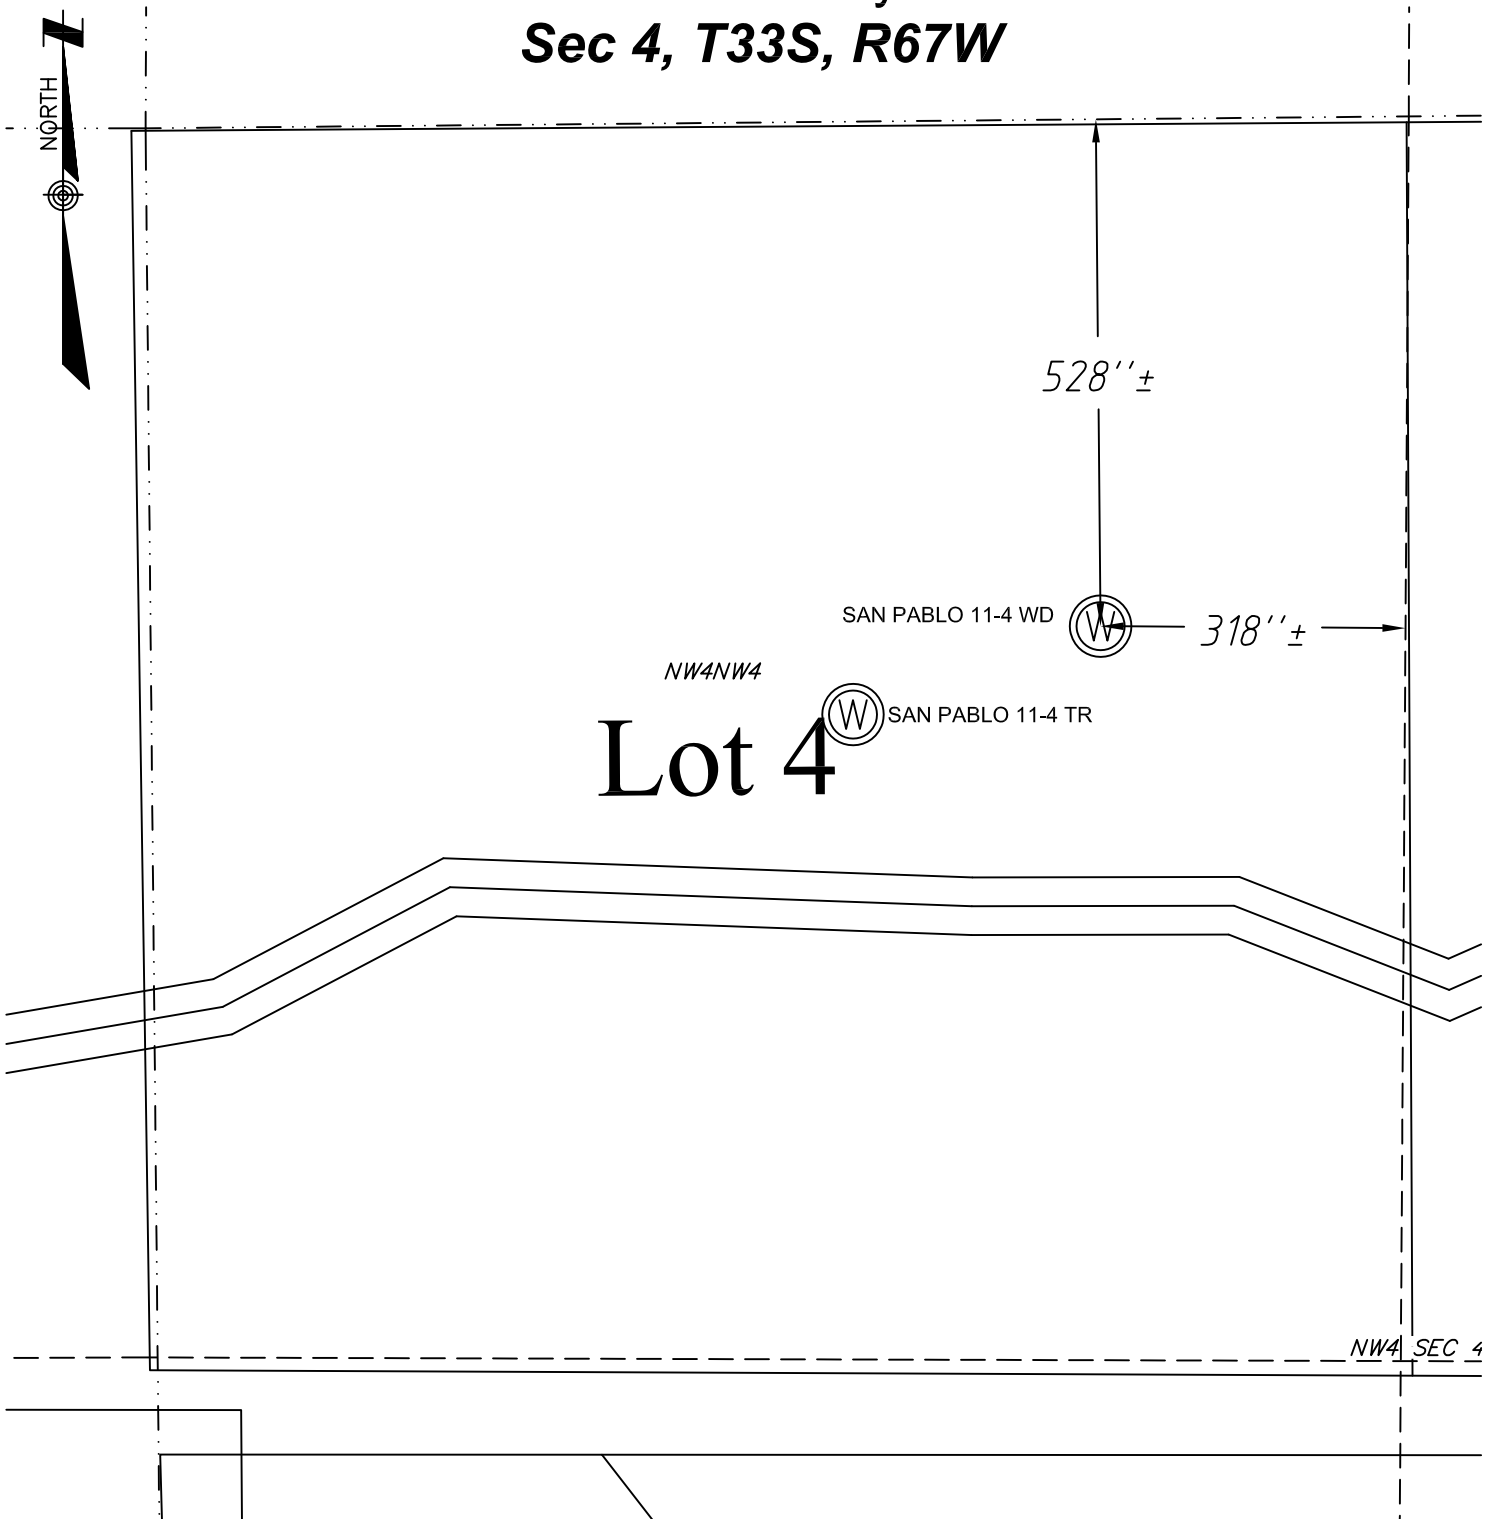

NOTE:
FOOTAGES GIVEN ARE ONLY ESTIMATES BASED ON
SUBDIVISION PLATS AND TIED TO EXISTING CONTROL.
A FULL BOUNDARY SURVEY IS REQUIRED TO DETERMINE
TRUE SUBDIVISION LOT AND ROAD LOCATIONS,
DISTANCES AND AREA OR FOOTAGE CALCULATIONS.

DATE: July 31, 2013

GRAPHIC SCALE

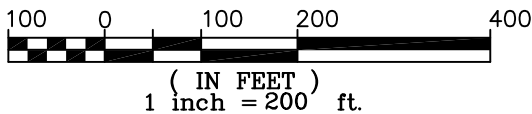

SHIELDS SURVEY L^{td}. C^o.
Raton, New Mexico 87740
(575)445-1232