




Lease Name: Lakes #31-33

Legals: NWSE – Sec. 31, T6N, R66W

County: Weld County, Colorado

API#: 05-123-28022

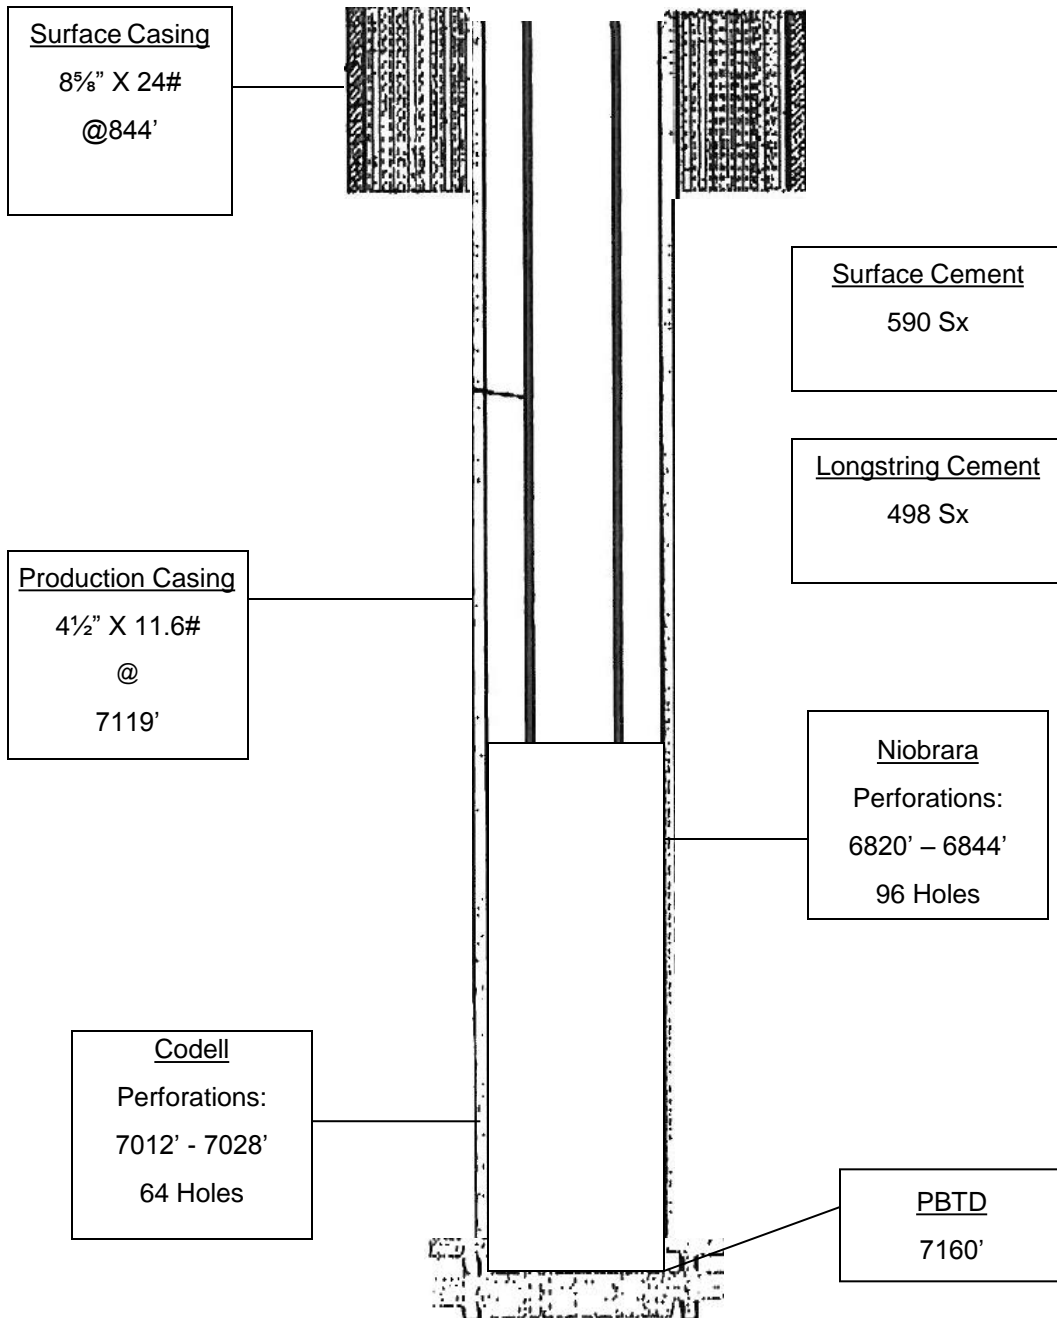

Wellbore Diagram