


**WPX Energy Rocky Mountain LLC  
Goldsborough PA 322-11  
Parachute Field**

**SHL 2403' FNL 2067' FWL (SE/4 NW/4) Section 11 T7S R95W 6th PM  
BHL 1739' FNL 2030' FWL (SE/4 NW/4) Section 11 T7S R95W 6th PM  
Garfield County Colorado**

**Formation Tops  
(Measured Depths)**

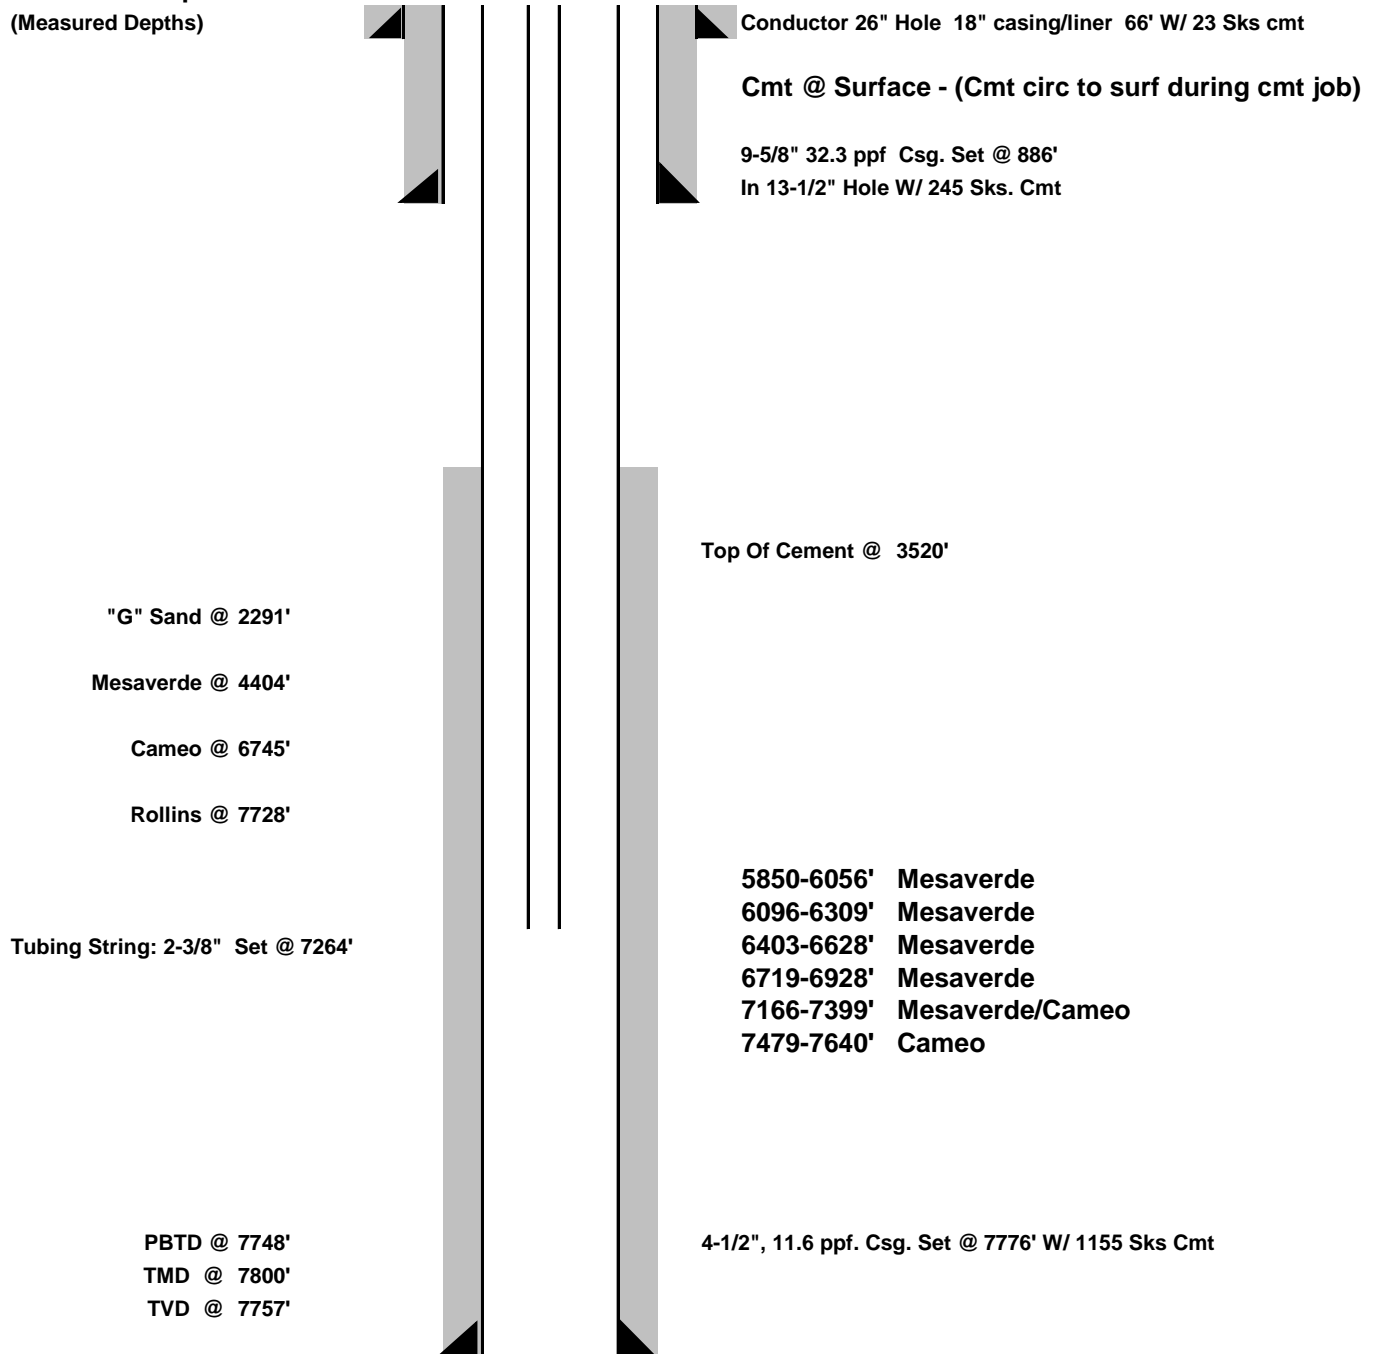

**NOTE: THIS IS NOT TO SCALE.**