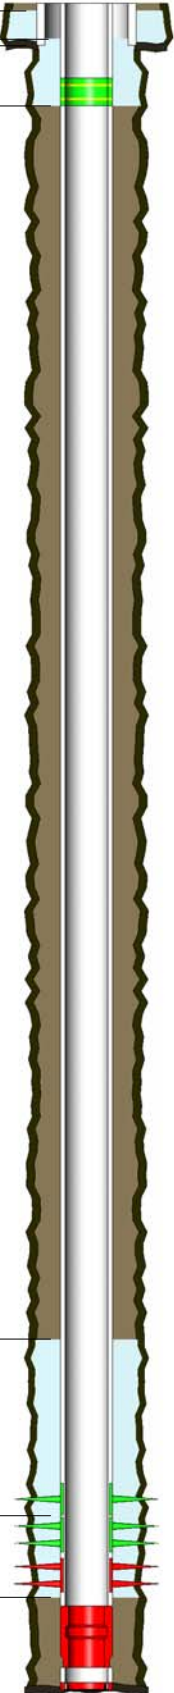


Casing Information	Casing Size & Weight	Cement Fluid (sacks)	Cement Depths (ft)	Schematic (9/14/2013)	Hole Size (in)	MD / PBMD (usft)	Perforation Intervals (usft)
SURFACE CASING - Set @ 235.1usft	8.625in, 28.00ppf 4.500in, 11.60ppf	, 2.4% CACL2, 200	50 (TOC) 200 (TOC) 235 413				
PRODUCTION CASING - Set @ 7, 929.8usft	4.500in, 11.60ppf	, 2% GEL 10% SALT 20% SS, 200 , 2% GEL, 200 , , 50	6996 (TOC) 7785 7860			MD: 7,930 PBMD: 7, 883	7,765 - 7,780 - J SAND 7,792 - 7,828 - J SAND 7,845 - 7,846 - J SAND