


**SURPRISE 12-54-36-6**  
**WELLBORE SCHEMATIC**

**Surface Loc:** SENW Sec 36, T12S, R54W  
**BH Loc:** SENW Sec 36, T12S, R54W  
**County:** LINCOLN **State:** COLORADO

38.96118° & -103.39978° (Nad 83) As Built  
7213' MD  
7213' TVD **API# 05-073-06540**

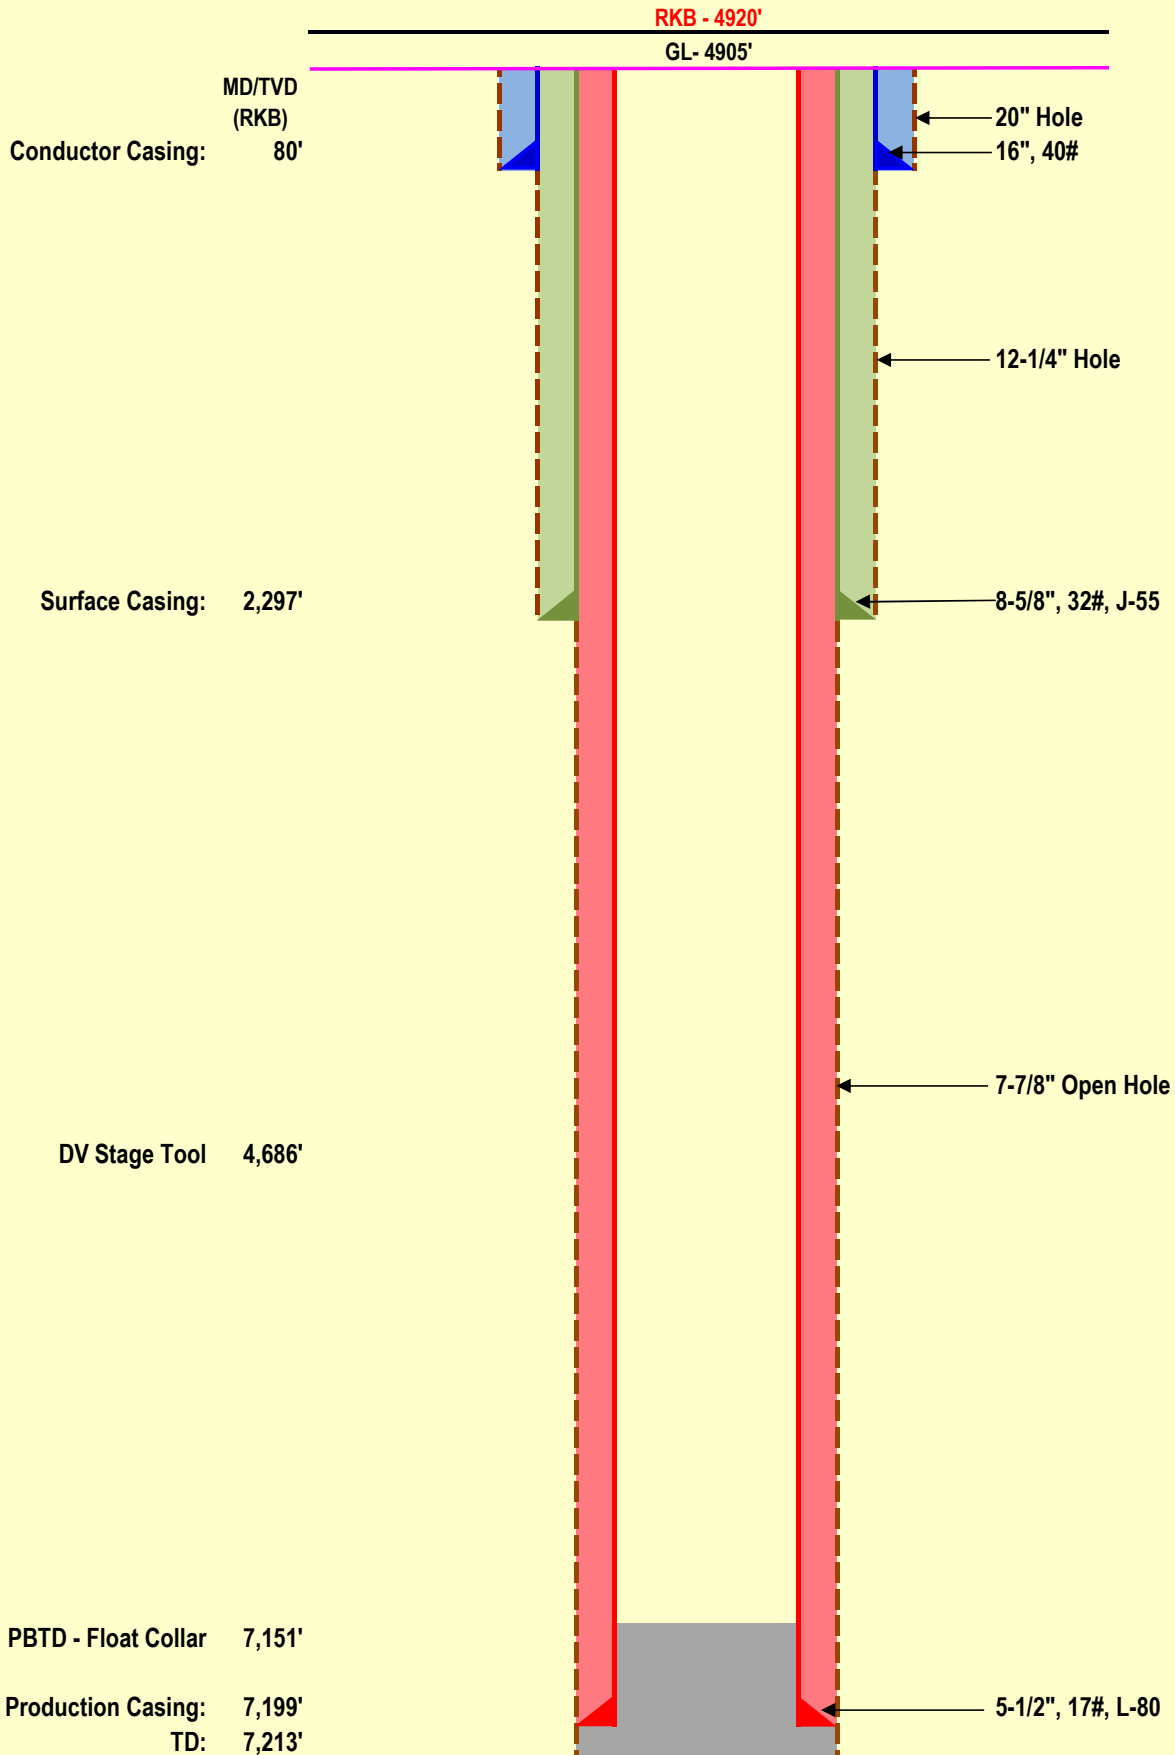

NOT TO SCALE