




Lease Name: State #16-1

Legals: NESE – Sec. 16, T4N, R67W

County: Weld County, Colorado

API#: 05-123-13680

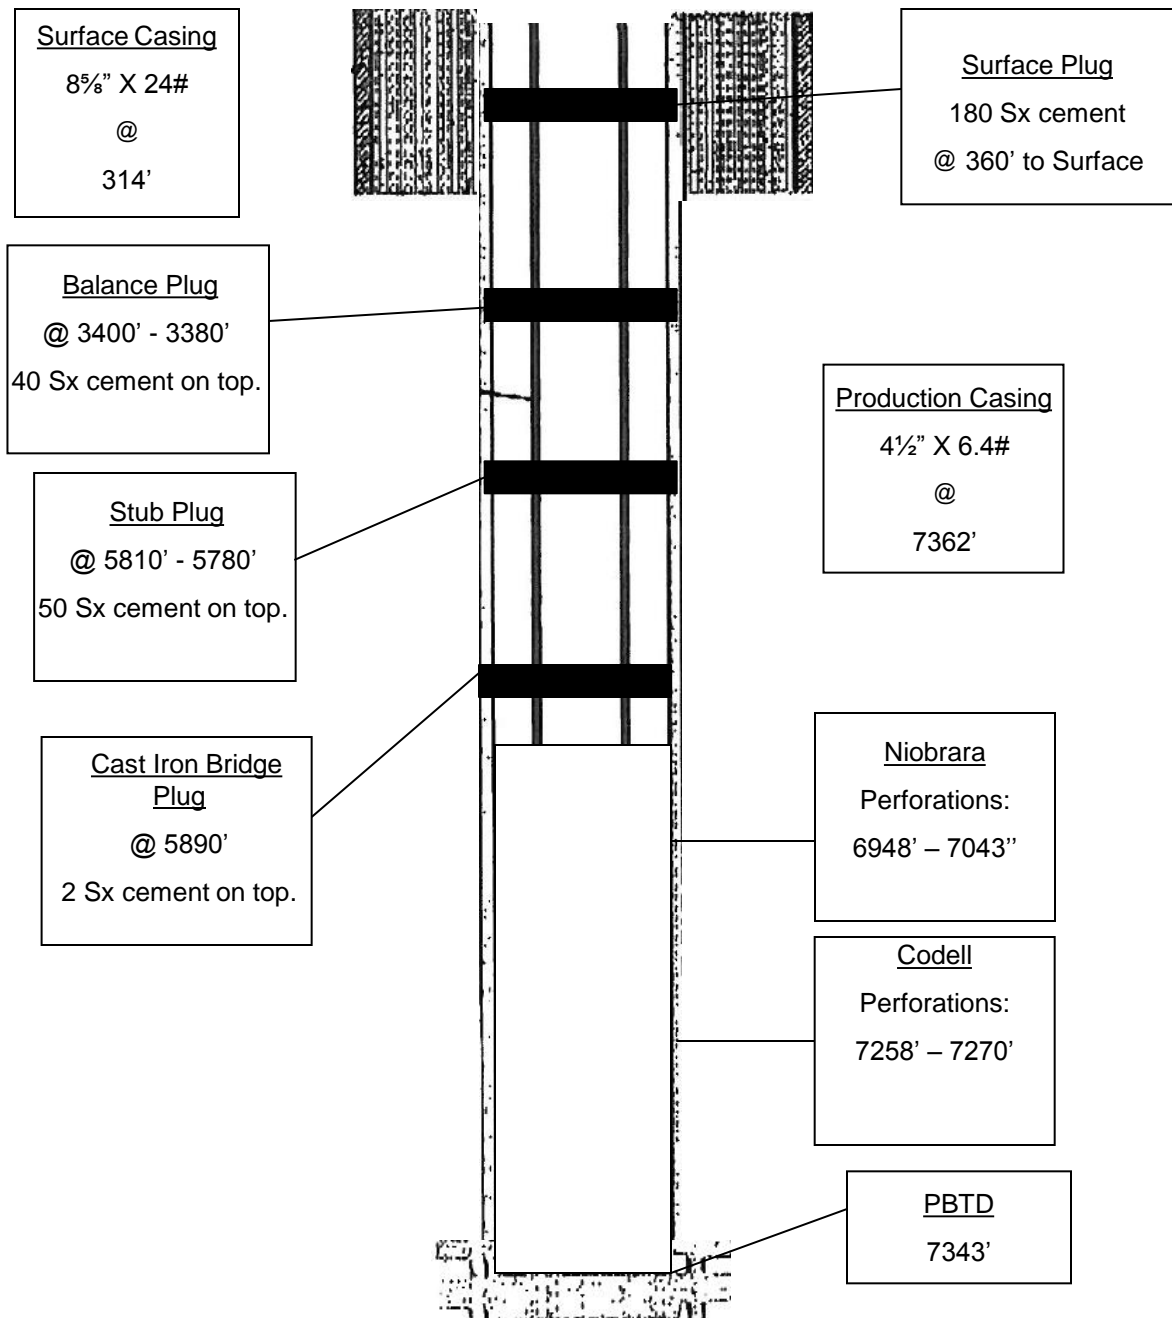

P & A Wellbore Diagram