




Well Plugged and Abandoned 08/16/2013

WELL NAME: Grassy Creek State #1 SPUD DATE: 7/11/1960 API# 05-107-05056-00
Loc: NW NW COMP DATE: AFE#
PROJECT AREA: Sec 36-T6N-R87W ID DATE: WELL CODE
COUNTY/STATE: Routt County, CO
Field: WILDCAT

KB: 14' GL: 7,193'

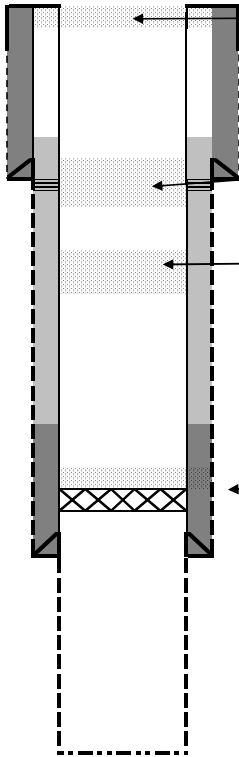

Set 45 sks cmt plug at surface.

SURFACE CASING:

DEPTH: 265' SIZE: 10 3/4" WT: 32.75 lb/ft GRADE: J-55 BIT SIZE: 17 1/2"
CEMENT: 250 sks cement

Perforate 316' and squeeze 100 sks cmt leaving 29 sks cmt in and out of surface casing from 316' - 174'.

INTERMEDIATE CASING:

DEPTH: SIZE: WT: GRADE: BIT SIZE:
CEMENT: 25 sks cmt plug from 2100' - 2083'

DV TOOL:

PRODUCTION CASING:

DEPTH: SIZE: 7" WT: 20.0 lb/ft GRADE: J-55 BIT SIZE: 8 1/2"
CEMENT: 100 sks cement
CIBP @4344 w/25 sks cmt on top. TOC 4218'

Open Hole: Open hole drilled to 4921'

TUBING:

DEPTH: SIZE: WT: GRADE: Packer:

Pumping Unit

COMPLETION:

STAGE	PERFS	Holes	FG (psi/ft)	Rate BPM	Fluid Used (gal)	40/70 White (lb)	20/40 White (lb)	20/40 CRC (lb)	Fluid Type
<u>Open Hole</u>									
<u>FRAC 1175 bbls oil 25,000# sand</u>									

TD: 4,935' PBTD: 4,921'