


**KERR-MCGEE OIL AND GAS ONSHORE LP**  
**ANDERSON FAMILY TRUST C 1**  
**SW NE 34 3N 68W -- --**  
**WELD,COLORADO**  
**08/30/2013**

**AREA: S2**      **ROUTE: S23**    **Spud: 11/16/1974**    **WINS No.: 74276**    **AFE/WO#: 88383385**    **API#: 0512307939**

**GL: 4938**    **KB: 4950**    **MTD: 7825**    **TVD: 7825**    **LOG MD:**    **PBMD: 7785**    **PBTVD: 7785**

**Directions:**    **I25 & WCR 28, W 2/10, S 1/4 INTO**

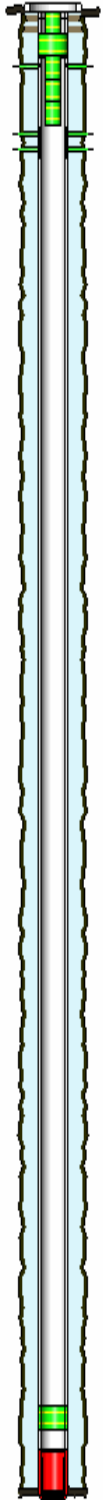

| <u>HOLE SECTIONS</u> | <u>Size</u>       | <u>Top</u>    | <u>Btm</u>         | <u>TD Date</u> |              |               |                 |                 |
|----------------------|-------------------|---------------|--------------------|----------------|--------------|---------------|-----------------|-----------------|
| SURFACE              | 12.25             | 12            | 220                | 11/16/1974     |              |               |                 |                 |
| PRODUCTION           | 7.88              | 220           | 7825               | 11/25/1974     |              |               |                 |                 |
| <u>TUBULARS</u>      | <u>Tool Type</u>  | <u>Joints</u> | <u>Size</u>        | <u>Weight</u>  | <u>Grade</u> | <u>Thread</u> | <u>Top D</u>    | <u>Bottom D</u> |
| SURFACE CASING       | Casing            | 4             | 8.63               | 24             | K-55         | STC           | 12              | 210             |
| PRODUCTION CASING    | Casing            | 3             | 4.50               | 11.6           | K-55         | STC           | 12              | 118             |
|                      | Casing            | 182           | 4.50               | 10.5           | K-55         | STC           | 118             | 7068            |
|                      | Casing            | 19            | 4.50               | 11.6           | K-55         | STC           | 7068            | 7785            |
|                      |                   | 1             | 4.50               |                |              |               | 7785            | 7786            |
|                      | Casing            | 1             | 4.50               | 11.6           | K-55         | STC           | 7786            | 7824            |
|                      | Casing Guide Shoe | 1             | 4.50               |                |              |               | 7824            | 7825            |
| PRODUCTION TUBING    |                   | 220           | 2.38               | 4.70           | J-55         | 8RD EUE       | 12              | 6971            |
|                      | Production        | 1             | 4.50               |                |              |               | 6971            | 6977            |
|                      |                   | 22            | 2.38               | 4.70           | J-55         | 8RD           | 6977            | 7667            |
|                      | XN Profile Nipple | 1             | 2.38               |                |              |               | 7667            | 7668            |
|                      | Notched Collar    | 1             | 2.38               |                |              |               | 7668            | 7669            |
| <u>CEMENT JOBS</u>   | <u>Stage</u>      | <u>Sacks</u>  | <u>Cement Jobs</u> | <u>Top D</u>   | <u>Btm D</u> | <u>cbl</u>    |                 |                 |
| SURFACE CASING       | STAGE 1           | 200           | REGULAR            | 50             | 208          | No            |                 |                 |
| PRODUCTION CASING    | STAGE 1           | 200           | 50/50 POZ-MIX      | 6900           | 7825         | Yes           |                 |                 |
| PRODUCTION CASING    | ONE INCH JOB      |               |                    | 3640           | 4440         | No            |                 |                 |
| PRODUCTION CASING    | ONE INCH JOB      |               |                    | 118            | 1164         | No            |                 |                 |
| <u>PERFORATIONS</u>  | <u>Formation</u>  | <u>Zone</u>   | <u>Top</u>         | <u>Btm</u>     | <u>Date</u>  | <u>Reason</u> | <u>Comments</u> |                 |
|                      | CODELL            |               | 7244               | 7266           | 11/07/1995   | PRODUCTION    |                 |                 |
|                      | J SAND            |               | 7680               | 7702           | 12/06/1974   | PRODUCTION    |                 |                 |

**Comments:**