


*Current*  
Well Completion Diagram

API Well No: 05-121-05453-00-					
Owner:	CORAL PRODUCTION CORP			Well Name:	CHRISTIANSON
County:	WASHINGTON	Field:	POD	Pool:	
Coordinates: X	660 FWL	; Y	660 FNL	Sec:	27 Twp: 3S R

Note: Changes to the drawing do not effect the database

Bore Diameters (in.)

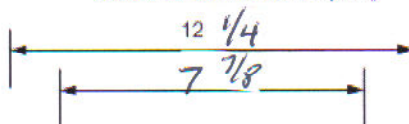

Cement Top: 0' mthd:U

Cement Top: 0' mthd:U

8 5/8" SURF 320'

Perfs 3,876-3,881'

5 1/2" 1ST 4,110'

