Company:	**US ROCKIES REGION**		**Site:**	**KUIPERS POOLING UNIT #2**	
Project:	**COLORADO-WELD-NAD83-UTM13**		**Common Well Name:**	**KUIPERS POOLING UNIT #2**	
API No:	0512309896	Datum: RKB	Section: 12		Div of Quarter Section: NE
Latitude:	40.156477°	Elevation: 4,843.0usft	Township: 2	N	Div of Section: NW
Longitude:	-104.842811°	Water Depth: 4,832.0usft	Range: 67	W	

Casing Information	Casing Size & Weight	Cement Fluid (sacks)	Cement Depths (ft)	Schematic (9/3/2013)	Hole Size (in)	MD / PBMD (usft)	Perforation Intervals (usft)
SURFACE CASING - Set @ 530.0usft	4.500in, 8.625in,	, , 450	0 (TOC) 50 (TOC) 521	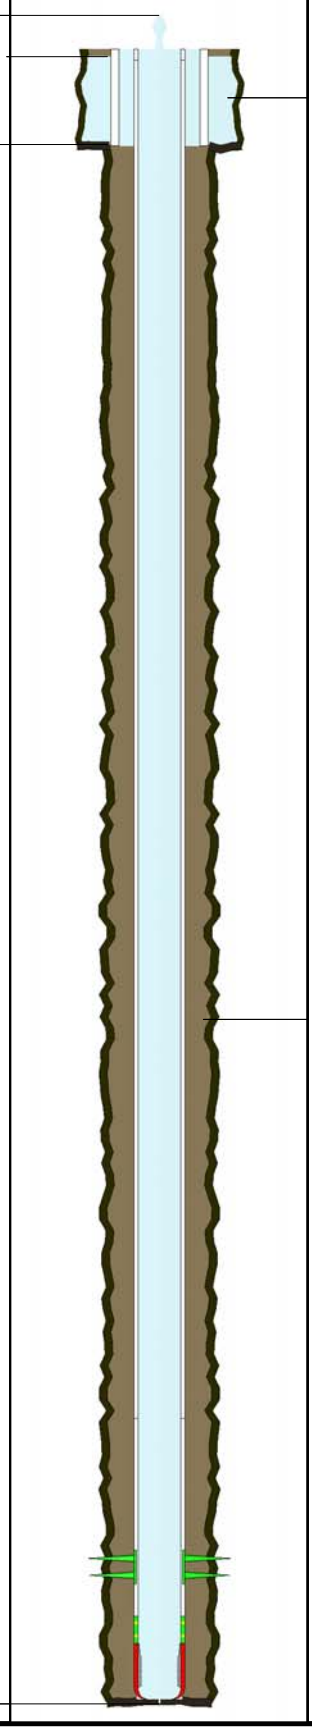	12.250		
PRODUCTION CASING - Set @ 7, 938.0usft	4.500in,	, , 200			7.875		
	4.500in,		7964			MD: 7,958 PBMD: 7, 920	7,784 - 7,850 - J SAND