Company:	**US ROCKIES REGION**			**Site:**	**NORGREN DONALD "E" #2**	
Project:	**COLORADO-WELD-NAD83-UTM13**			**Common Well Name:**	**NORGREN DONALD "E" #2**	
API No:	0512310281	Datum:	RKB	Section:	1	Div of Quarter Section: SW
Latitude:	40.170146°	Elevation:	4,837.0usft	Township:	2 N	Div of Section: NW
Longitude:	-104.844357°	Water Depth:	4,824.0usft	Range:	67 W	

Casing Information	Casing Size & Weight	Cement Fluid (sacks)	Cement Depths (ft)	Schematic (9/5/2013)	Hole Size (in)	MD / PBMD (usft)	Perforation Intervals (usft)
SURFACE CASING - Set @ 704.0usft	4.500in, 8.625in,	, , 500	10 (TOC) 704	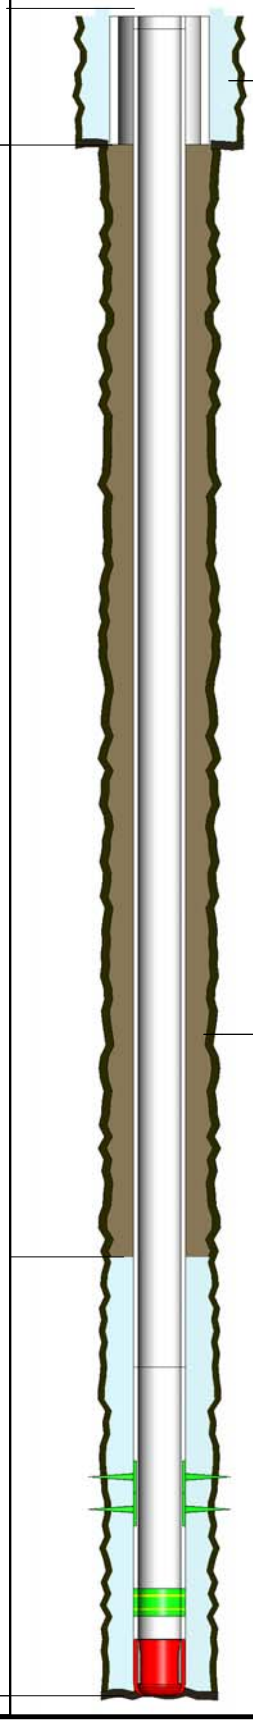	12.250		
PRODUCTION CASING - Set @ 7,970.0usft	4.500in,				7.875		
	4.500in,	, 2% GEL 10% SALT 20% SILIC, 200	6679 (TOC)				7,774 - 7,791 - J SAND 7,795 - 7,830 - J SAND
	4.500in,		7970			MD: 7,970 PBMD: 7,923	