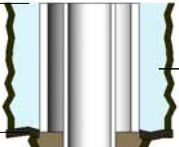
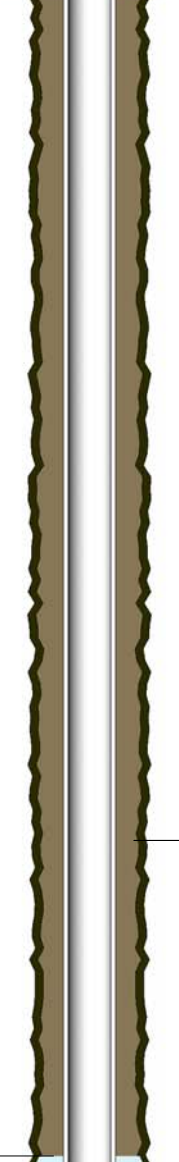
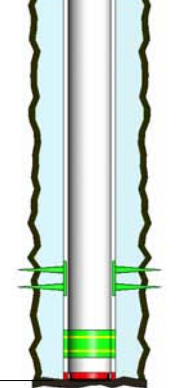


Casing Information	Casing Size & Weight	Cement Fluid (sacks)	Cement Depths (ft)	Schematic (9/5/2013)	Hole Size (in)	MD / PBMD (usft)	Perforation Intervals (usft)
SURFACE CASING - Set @ 671.0usft	8.625in,	, 3% CACL2 1/ 4 #/sk Flocel, 485	12 (TOC)  671		12.250		
PRODUCTION CASING - Set @ 7,940.0usft	4.500in,		6657 (TOC)		7.875		
	4.500in,	, 35% SILICA - 3% KCl, 250	7940			MD: 7,956 PBMD: 7,926	7,766 - 7,830 -