WINS:	73780		API:	05-123-08130

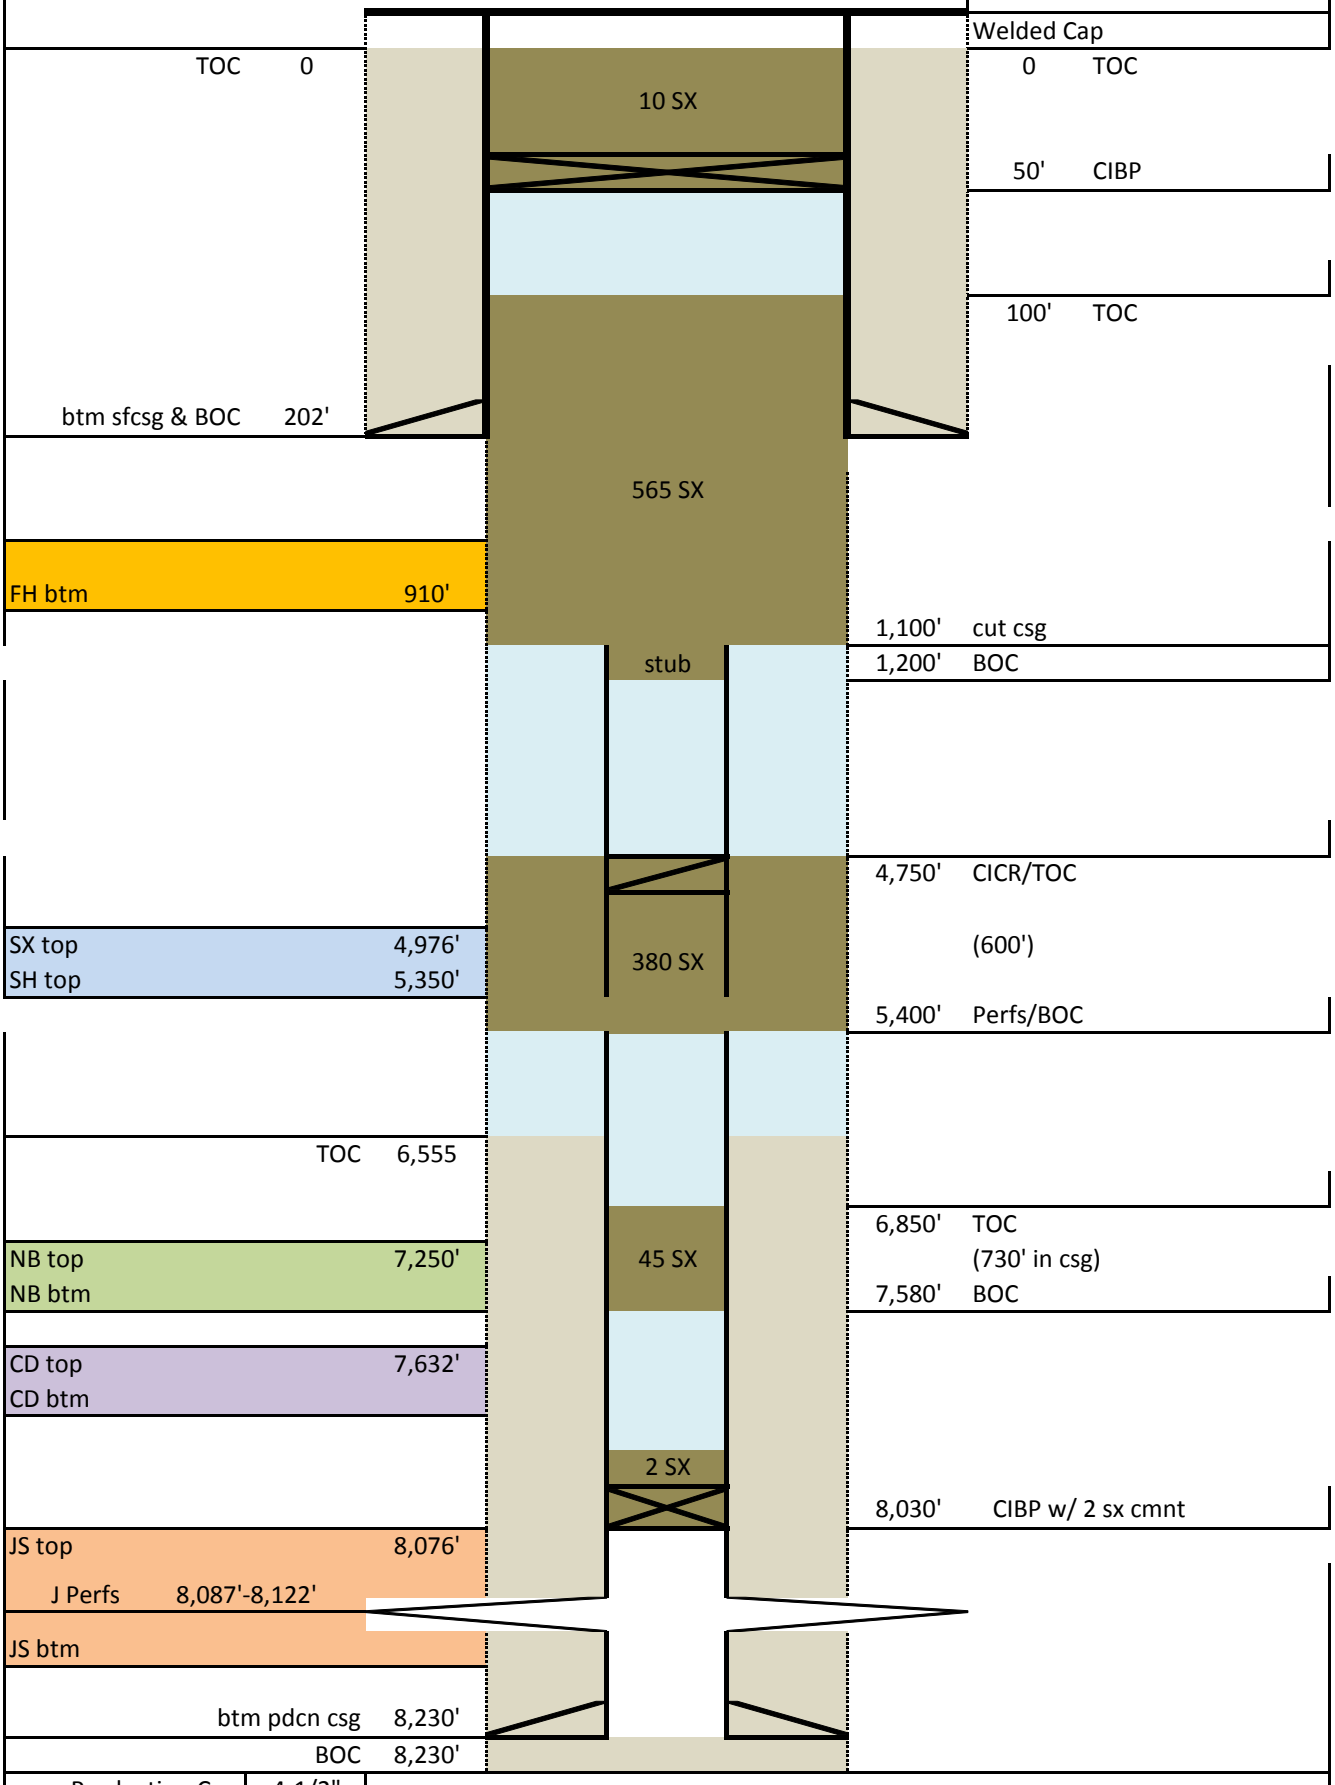

Production Csg:	4-1/2"
Surface Csg:	8-5/8"
Production Tbg:	2-3/8"