Company:	**US ROCKIES REGION**			**Site:**	**REED W DOUGLAS GU #1**
Project:	**COLORADO-WELD-NAD83-UTM13**			**Common Well Name:**	**REED W DOUGLAS GU #1**
API No:	0512308130	Datum:	DFE	Section: 25	Div of Quarter Section: NW
Latitude:	40.018736°	Elevation:	0.0usft	Township: 1 N	Div of Section: SW
Longitude:	-104.844188°	Ground:		Range: 67 W	

Casing Information	Casing Size & Weight	Cement Fluid (sacks)	Cement Depths (ft)	Schematic (9/10/2013)	Hole Size (in)	MD / PBMD (usft)	Perforation Intervals (usft)
8 5/8 IN CASING - Set @ 202.0usft	8.625in,	LEAD, , 200	0 (TOC) 0 (TOC) 202	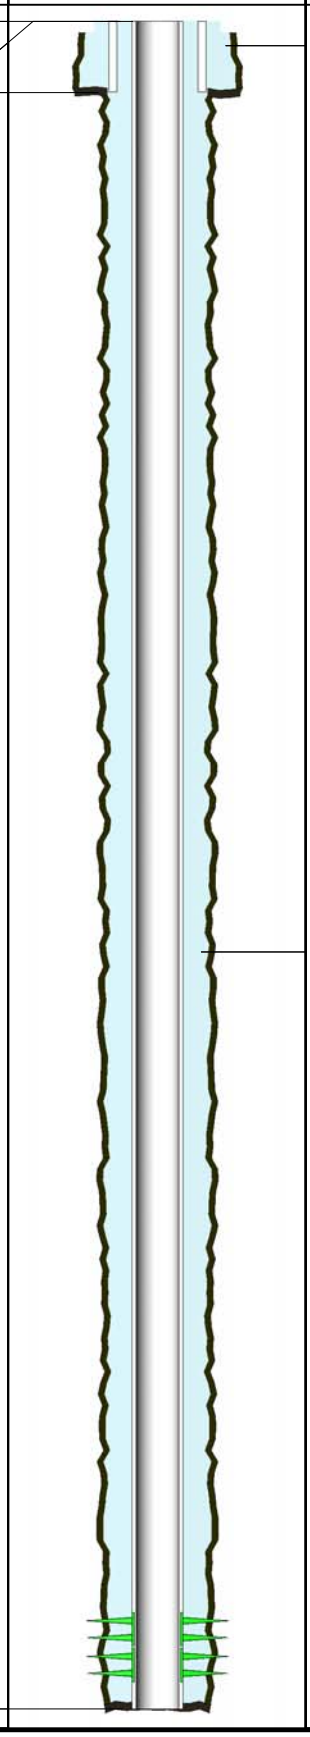	12.250		
4 1/2 IN CASING - Set @ 8,230.0usft	4.500in, 11.60ppf	LEAD, , 400	8230		7.875	MD: , PBMD:	8,087 - 8,093 - DAKOTA J/ SD/ 8,102 - 8,122 - DAKOTA J/ SD/