

Well

Operator

Location

County

State

Field

Footages

IONE 2-8-2

EnCana Oil & Gas (USA) Inc.

SWSW Section 2-T2N-R66W

WELD

Colorado

Wattenberg

846' FSL; 1077' FWL

Spud Date: 01/21/2013

TD Date: 01/24/2013

Log Tops

Sussex4586'


Niobrara7345'

Codell7550'

J Sand7998'

Production Tubing

2-3/8" tubing, set @7981.78'

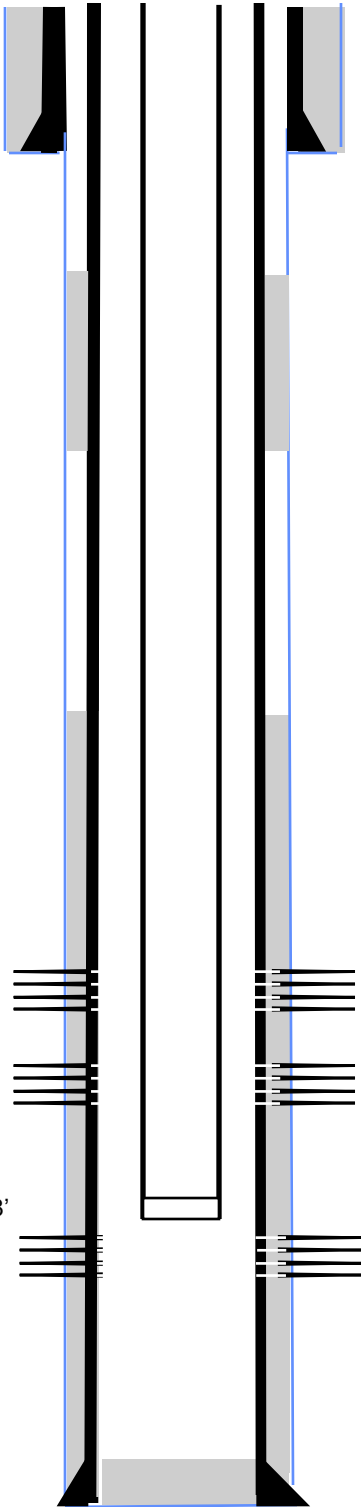

Surface Casing and Cement

8 5/8" , 24#, landed @ 879',cemented with 350 sxs

Main Hole

7-7/8" to TD

Production Casing and Cement

4-1/2" , 11.6#, landed @ 8167',cemented with 650 sxs

CBP

Set @ 7330'. 06-22-13

Drilled out on 06-28-13

Perf'd the Niobrara from 7397' - 7412' @ 4 spf

Frac'd the Nio B with 150,240# 40/70 with 80,083 gals SLF.

05-15-13

CFP

Set @ 7452' . 05-15-13

Drilled out on 06-28-13

Perf'd the Codell from 7551' – 7568' @ 3 spf

Frac'd the Codell with 150,240# 40/70 with 85,328 gals SLF.

05-14-13

CFP

Set @ 7618'. 05-14-13

Drilled out on 06-28-13

Perf'd the J Sand from 7999' – 8001', 8035' – 8054' @ 3 spf

Frac'd the J Sand with 150,000# 40/70 with 93,033 gals SLF.

05-14-13