

Well

Operator

Location

County

State

Field

Footages

KAWAKAMI 4-0-35

EnCana Oil & Gas (USA) Inc.

NWNE Section 35-T3N-R67W

WELD

Colorado

Wattenberg

413' FNL; 1933' FEL

Spud Date:

01-26-2013

TD Date:

01-30-2013

Log Tops

Sussex

4272'

Niobrara


7128'

Codell

7389'

J Sand

7830'

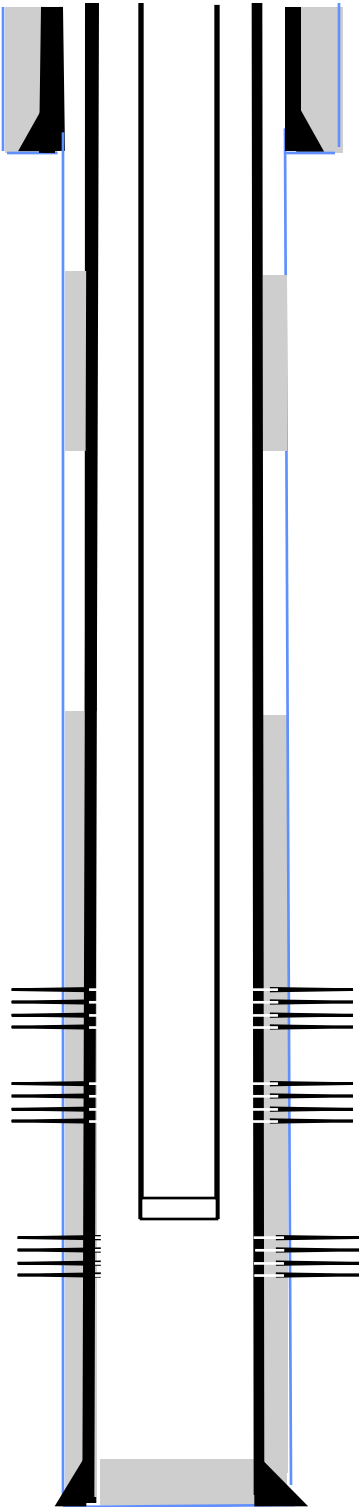

Surface Casing and Cement
8 5/8" , 24#, landed @ 796',cemented with 310 sxs

Main Hole
7-7/8" to TD

Production Casing and Cement
4-1/2", 11.6#, landed @ 7976',cemented with 680 sxs

CBP
Set @ 7120'. 04-03-13
Drilled out on 04-05-13

Perf'd the Niobrara from 7171' – 7190' @ 4 spf
Frac'd the Niobrara with 100,120# 40/70 and 93,017 gals SLF.
04-03-13

CFP
Set @ 7240'. 04-03-13
Drilled out on 04-05-13

Perf'd the Codell from 7391' – 7410' @ 3 spf
Frac'd the Codell with 98,380# 40/70 # 40/70 sand and 94,252 gals SLF. 04-03-13

CFP
Set @ 7458'. 04-03-13
Drilled out on 04-05-13

Perf'd the J Sand from 7831'-7840' , 7854'-7870' @ 3 spf
Frac'd the J Sand with 102,100# 40/70 sand and 94,569 gals SLF.
04-03-13

Production Tubing
2-3/8" tubing, set @ 7793'

7990' — Driller's TD