

Well Name: Jones Laurance Gas Unit A 3

API #:


05-067-09659-00

Location: SE/4, SEC. 7U, T34N, R7W La Plata County, Colorado

Elevation: GL 6871', KB 6887'

Date: 12-Sep-2013

Spud Date: Mar-2009

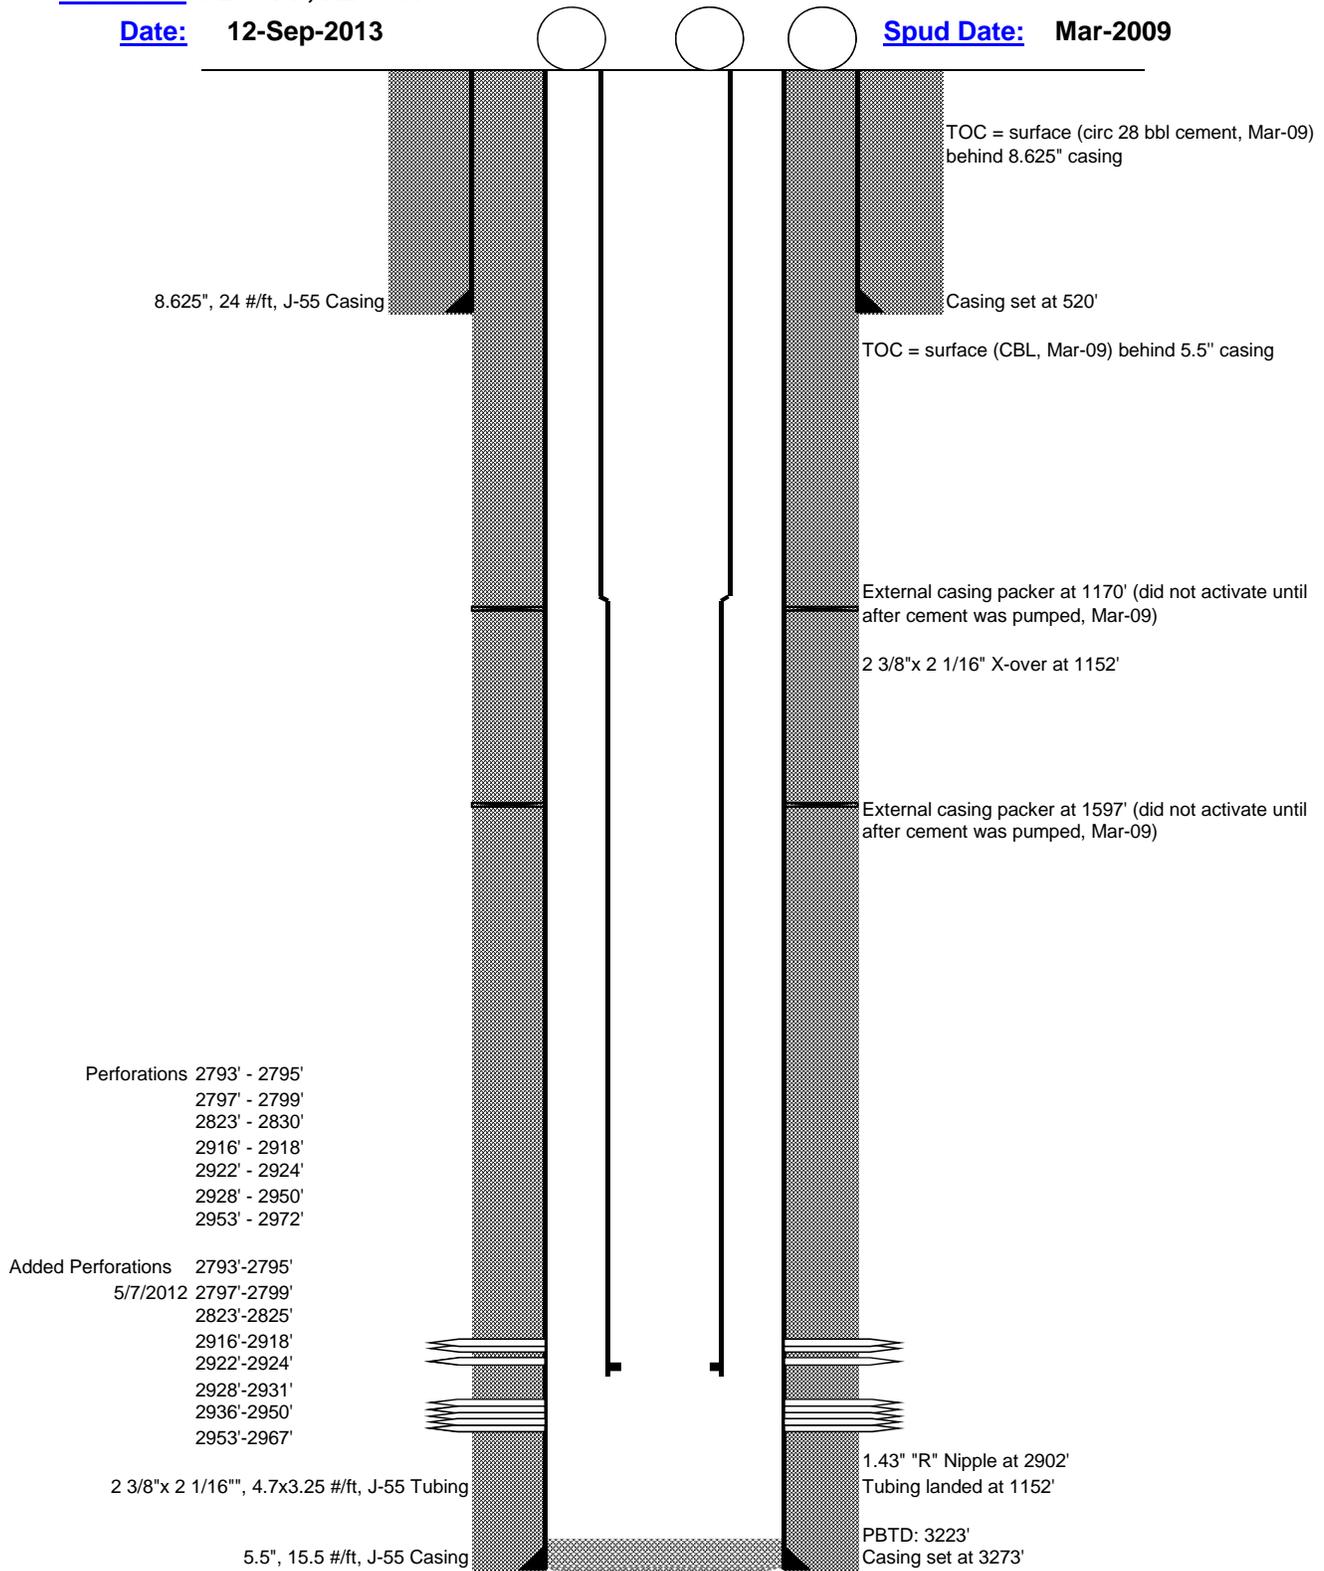

TD: 3284'