


Wellbore Diagram

(Current 8/27/13) ****Revised 9/18/2013**

Elev. GL: 5,585'
KB: 5,610'

Spud: 4/28/2008
TD: 6/9/2008

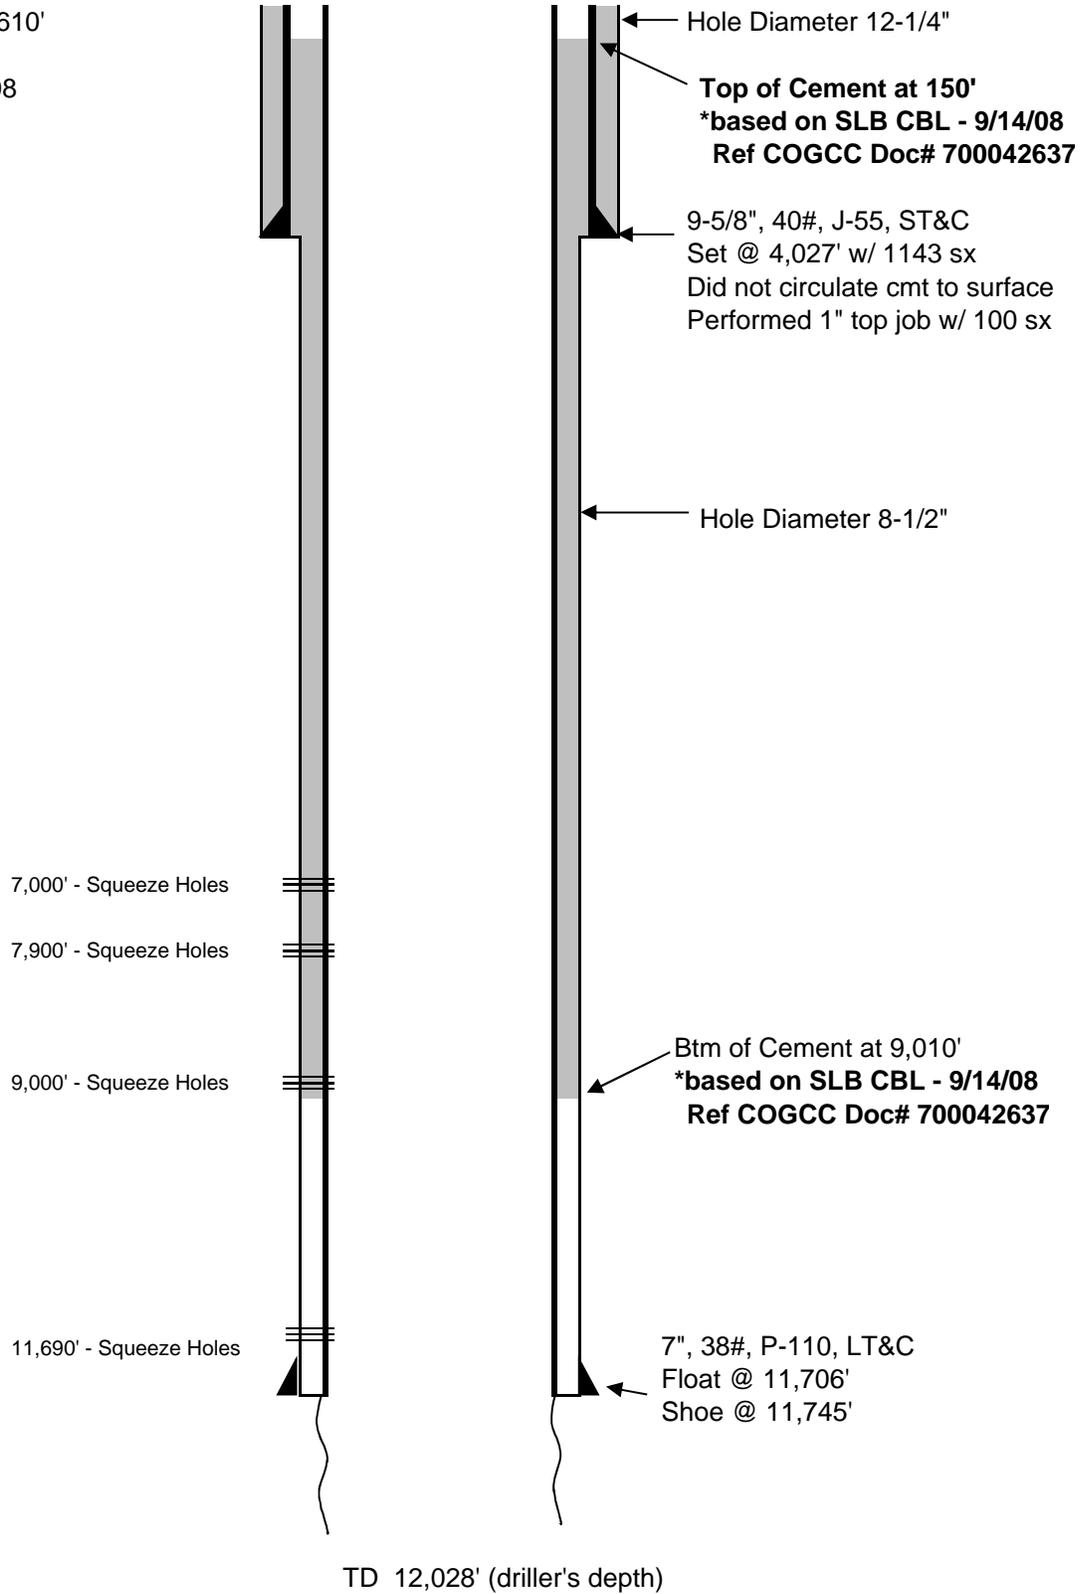

Ursa Operating Company

Dever C7

API: 05045-14945-0000

DPY, 8/27/13