


Current Wellbore Schematic

Encana Oil & Gas (USA) Inc.



WELL : Rasmussen 4-2-28 DIRECTIONAL
 LOCATION : SENW Sec. 28 – T2N – R68W
 COUNTY : WELD STATE: CO
 FIELD : WATTENBERG
 ELEVATION : 4935' (GL) 4948' (KB) Δ13'

SPUD DATE: 02/28/2013
 COMPL. DATE: 04/23/13
 API #: 05123328930000

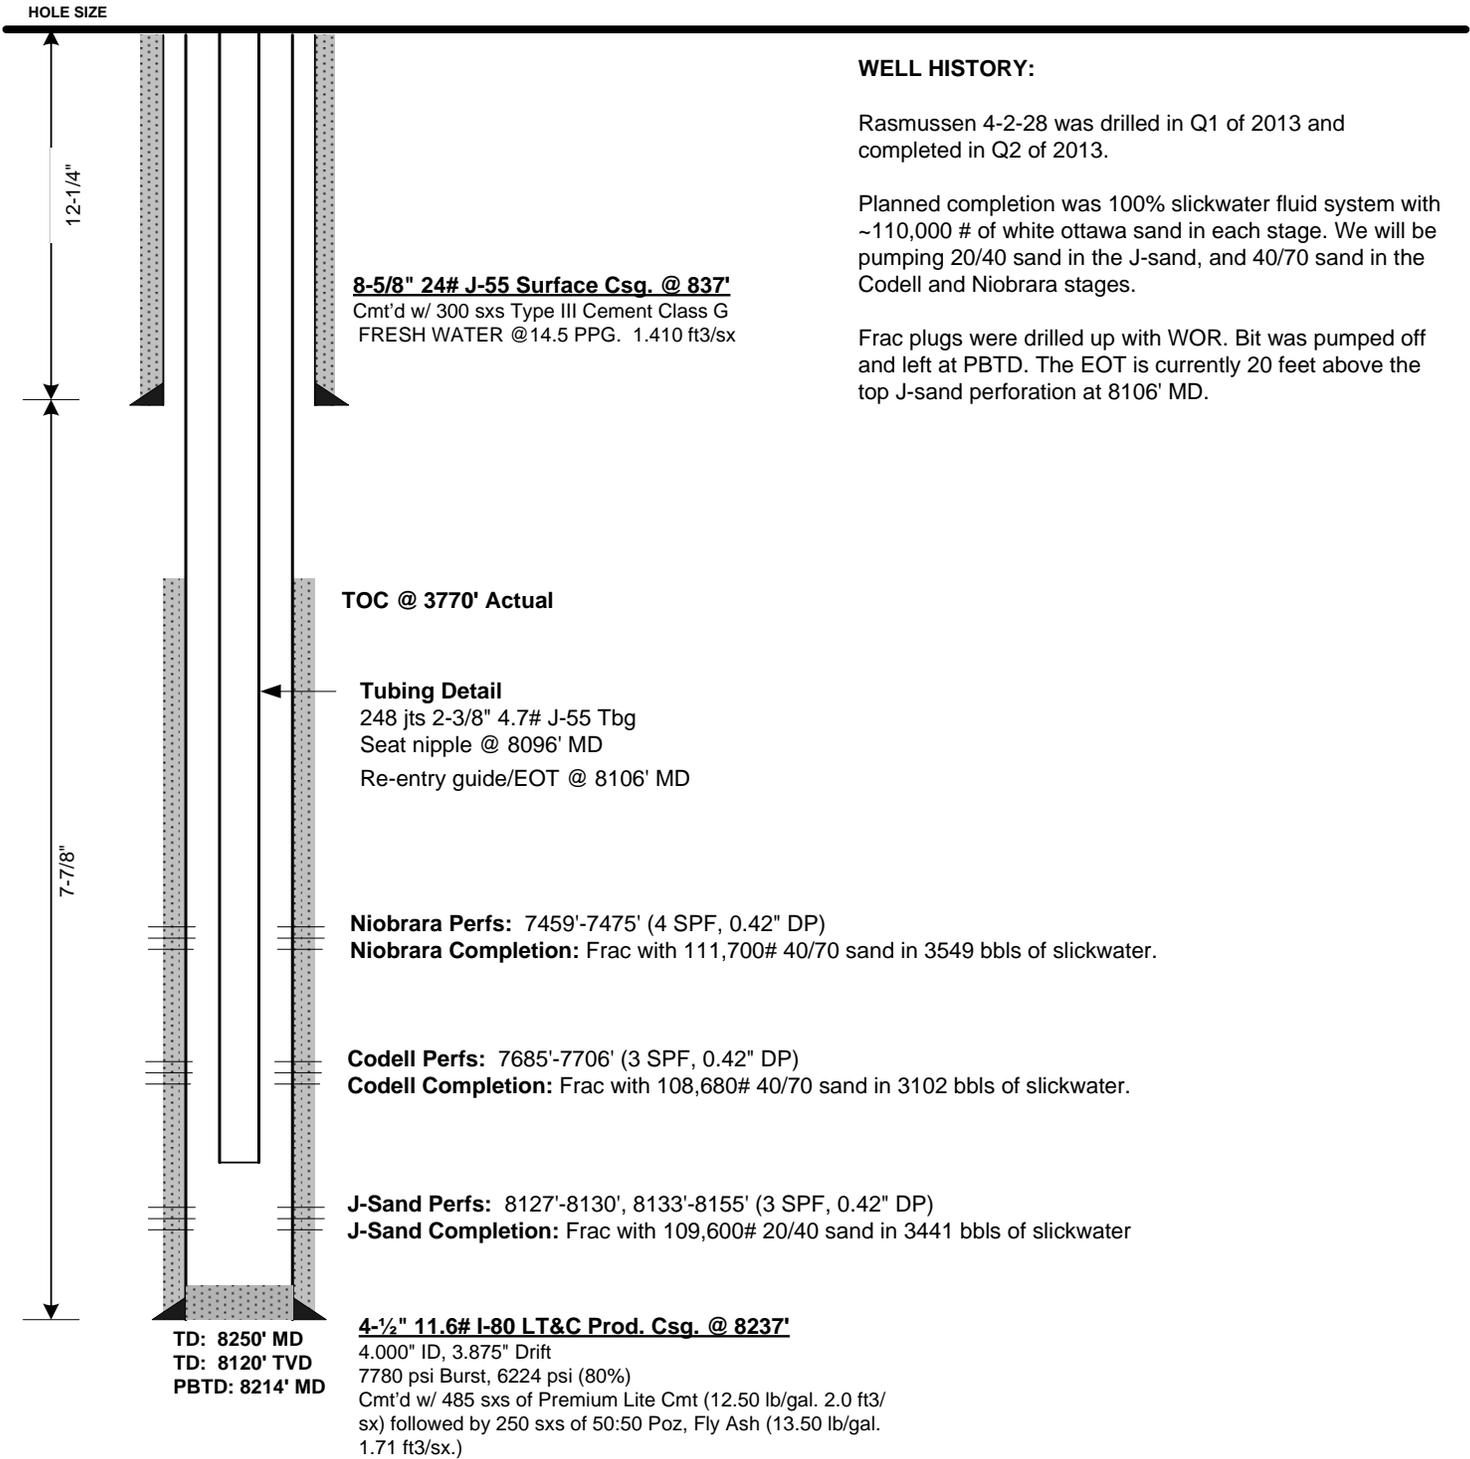

WELL HISTORY:

Rasmussen 4-2-28 was drilled in Q1 of 2013 and completed in Q2 of 2013.

Planned completion was 100% slickwater fluid system with ~110,000 # of white ottawa sand in each stage. We will be pumping 20/40 sand in the J-sand, and 40/70 sand in the Codell and Niobrara stages.

Frac plugs were drilled up with WOR. Bit was pumped off and left at PBTD. The EOT is currently 20 feet above the top J-sand perforation at 8106' MD.