

KERR-MCGEE OIL AND GAS ONSHORE LP

UPRR 42 PAN AM N NAV 1

SW SW 17 1N 67W -- --

WELD,COLORADO

09/23/2013

AREA: S3

ROUTE: S35 Spud: 08/10/1974

WINS No.: 73796

AFE/WO#: 2086322

API#: 0512308105

GL: 5127

KB: 5137

MTD: 8390


TVD: 8390

LOG MD:

PBMD: 8345

PBTVD: 8345

Directions: RD 15 & RD 8, E 3/10 MI, N 1/4 MI TO LOCATION

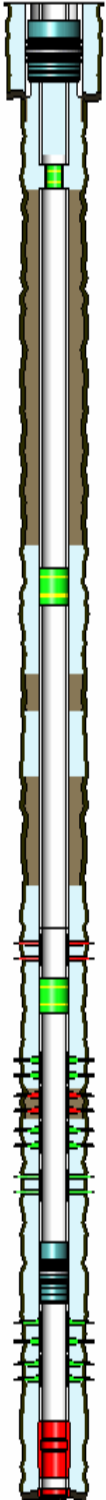

<u>HOLE SECTIONS</u>	<u>Size</u>	<u>Top</u>	<u>Btm</u>	<u>TD Date</u>				
SURFACE	12.25	10	235	08/10/1974				
PRODUCTION	7.88	235	8390	09/09/1974				
<u>TUBULARS</u>	<u>Tool Type</u>	<u>Joints</u>	<u>Size</u>	<u>Weight</u>	<u>Grade</u>	<u>Thread</u>	<u>Top D</u>	<u>Bottom D</u>
SURFACE CASING	Casing	7	8.63	24.00	K-55	STC	10	235
PRODUCTION (LONG STRING) CASING	Casing	3	4.50	11.60	K-55	LTC	10	99
	Casing	17	4.50	10.50	K-55	BTC	99	843
	Cement Stage Too	1					843	844
	Casing	161	4.50	10.50	K-55	BTC	844	7087
	Casing	37	4.50	11.60	K-55	LTC	7087	8354
	Float Collar	1					8354	8355
	Casing	1	4.50	11.60	K-55	LTC	8355	8387
	Casing Guide Shoe	1					8387	8388
BRIDGE PLUG	Bridge Plug	1	4.50				8200	8201
CAST IRON CEMENT RETAINER	Cement Retainer	1	4.50				7240	7241
CAST IRON CEMENT RETAINER	Cement Retainer	1	4.50				4200	4201
BRIDGE PLUG	Bridge Plug	1	8.63				100	102
<u>CEMENT JOBS</u>	<u>Stage</u>	<u>Sacks</u>	<u>Cement Jobs</u>	<u>Top D</u>	<u>Btm D</u>	<u>cbf</u>		
SURFACE CASING	STAGE 1	200	REGULAR	10	234	No		
PRODUCTION (LONG STRING) CASING	PRIMARY	200	DJ - 50/50 POZ-MIX	7632	8390	Yes		
	STAGE 2 LEAD	200	DJ - 50/50 POZ-MIX	474	844	Yes		
PRODUCTION (LONG STRING) CASING	SQUEEZE (CSG)	300	DJ - G	5150	5726	No		
PRODUCTION (LONG STRING) CASING	SQUEEZE (CSG)	135	DJ - G	7100	7624	No		
	SQUEEZE (CSG)	100	DJ - G	6700	7136	No		
PRODUCTION (LONG STRING) CASING	ABANDONMENT PLUC	80	LEAD FRESH WATER	7000	7430	No		
	ABANDONMENT PLUC	450	TAIL FRESH WATER	4005	4820	No		
SURFACE CASING	ABANDONMENT PLUC	175	LEAD FRESH WATER	105	748	No		
<u>PERFORATIONS</u>	<u>Formation</u>	<u>Zone</u>	<u>Top</u>	<u>Btm</u>	<u>Date</u>	<u>Reason</u>	<u>Comments</u>	
	NIOBRARA		4180	4182	08/14/2013	CEMENT SQUEEZE		
	NIOBRARA		4815	4816	08/14/2013	CEMENT SQUEEZE		
			7136	7137	01/03/1985	CEMENT SQUEEZE		
	NIOBRARA		7210	7211	08/13/2013	CEMENT SQUEEZE		
	NIOBRARA		7430	7431	08/13/2013	CEMENT SQUEEZE		

KERR-MCGEE OIL AND GAS ONSHORE LP

UPRR 42 PAN AM N NAV 1

SW SW 17 1N 67W -- --

WELD,COLORADO

09/23/2013

AREA: S3

ROUTE: S35

Spud: 08/10/1974

WINS No.: 73796

AFE/WO#: 2086322

API#: 0512308105

GL: 5127

KB: 5137

MTD: 8390

TVD: 8390

LOG MD:

PBMD: 8345

PBTVD: 8345

Directions:

RD 15 & RD 8, E 3/10 MI, N 1/4 MI TO LOCATION

NIOBRARA	7580	7582	01/16/1985	PRODUCTION
	7624	7625	01/03/1985	CEMENT SQUEEZE
NIOBRARA	7664	7670	01/16/1985	PRODUCTION
CODELL	7814	7822	01/16/1985	PRODUCTION
J SAND	8256	8304	05/13/1980	PRODUCTION
J SAND	8268	8273	09/14/1974	PRODUCTION
J SAND	8280	8287	09/14/1974	PRODUCTION

Comments: