Company:	**US ROCKIES REGION**			**Site:**	**SHAW FLOYD C UNIT #1**
Project:	**COLORADO-WELD-NAD83-UTM13**			**Common Well Name:**	**SHAW FLOYD C UNIT #1**
API No:	0512307741	Datum:	RKB	Section: 1	Div of Quarter Section: SW
Latitude:	40.162434°	Elevation:	4,841.0usft	Township: 2 N	Div of Section: SW
Longitude:	-104.844196°	Ground:	4,831.0usft	Range: 67 W	

Casing Information	Casing Size & Weight	Cement Fluid (sacks)	Cement Depths (ft)	Schematic (9/25/2013)	Hole Size (in)	MD / PBMD (usft)	Perforation Intervals (usft)
SURFACE CASING - Set @ 632.0usft	4.500in, 11.60ppf 8.625in, 23.00ppf 4.500in, 10.50ppf	, 2% CACL2, 2% GEL, 300 200	10 (TOC) 200 (TOC) 400 632 912	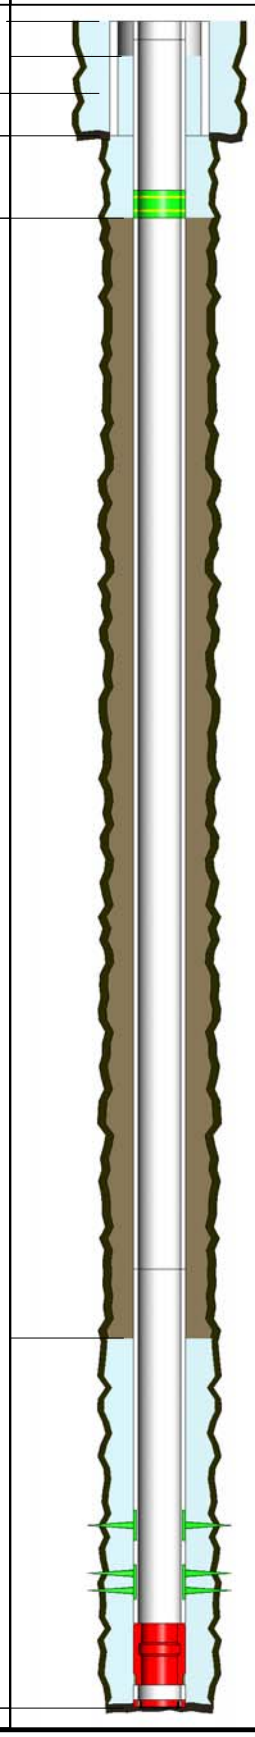			
PRODUCTION CASING - Set @ 7, 960.0usft	4.500in, 10.50ppf 4.500in, 11.60ppf 4.500in, 11.60ppf	, 10%SALT 20% SILICA, 200 , 2% GEL, 200	7000 (TOC) 7960			MD: 7,964 PBMD: 7, 906	7,786 - 7,800 - J SAND 7,812 - 7,840 - J SAND