


KERR-MCGEE OIL AND GAS ONSHORE LP
WILLIAM KATCHEN ET AL #1
SWSE -- 3 2N 65W 640' FSL 1,980' FEL
WELD,COLORADO
09/26/2013

AREA: S5 ROUTE: S54 Spud: 04/19/1955 WINS No.: F9384 AFE/WO#: 2075715 API#: 0512305100

GL: 4832 KB: 4842 MTD: 8938 TVD: 8938 LOG MD: 8941 PBMD: PBTVD:

Directions: WCR 26 & WCW 43, E 5/10, S 3/10, SE 2/10, S ACROSS CATTLE GUARD, W 1/10, S 3/10, E INTO

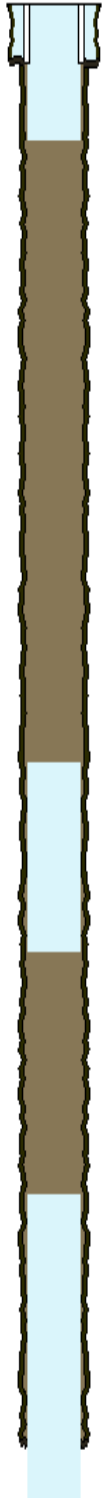

HOLE SECTIONS	Size	Top	Btm	TD Date
SURFACE	12.25	10	312	04/19/1955
INTERMEDIATE	8.75	312	7578	05/01/1955
PRODUCTION	7.88	7578	8938	06/04/1955

TUBULARS	Tool Type	Joints	Size	Weight	Grade	Thread	Top D	Bottom D
SURFACE CASING	Casing		9.63	32.30			10	312

CEMENT JOBS	Stage	Sacks	Cement Jobs	Top D	Btm D	cbl
SURFACE CASING	STAGE 1	170	UNKNOWN W/ 6% GEL	10	312	No
SURFACE CASING	ABANDONMENT PLUC	5	COMMON	10	25	No
	ABANDONMENT PLUC	20	COMMON	280	330	No
	ABANDONMENT PLUC	100	SLO-SET	7550	7890	No
SURFACE CASING	ABANDONMENT PLUC	200	LEAD FRESH WATER	6907	7580	No
SURFACE CASING	ABANDONMENT PLUC	200	LEAD FRESH WATER	6275	6938	No
	ABANDONMENT PLUC	75	LEAD-2 FRESH WATER	6280	6535	No
	ABANDONMENT PLUC	250	LEAD-2 FRESH WATER	4449	4992	No
	ABANDONMENT PLUC	250	TAIL FRESH WATER	4000	4449	No
SURFACE CASING	ABANDONMENT PLUC	150	LEAD FRESH WATER	300	729	No
	ABANDONMENT PLUC	150	LEAD-2 FRESH WATER	10	364	No

PERFORATIONS	Formation	Zone	Top	Btm	Date	Reason	Comments
--------------	-----------	------	-----	-----	------	--------	----------

Comments: