Wellbore Schematic

noble energy

Well Name: CECIL USX A01-13

VERTICAL - ORIGINAL HOLE, 9/30/2013 10:01:36 AM

MD (ftKB)	Incl (°)	TVD (ftKB)	Vertical schematic (actual)
0.0			
12.8			
13.1			
14.1			
15.7			
25.6			
439.0			
759.2			
760.2			
804.1			
805.1			
813.0			
899.9			
6,671.9			
6,682.4			
6,683.7			
6,684.1			
6,686.4			
6,704.1			
6,720.1			
6,784.1			
6,826.1			
6,841.9			
6,867.1			
6,876.0			
6,882.9			
7,011.2			
7,067.3			
7,068.2			
7,110.6			
7,112.2			
7,118.1			

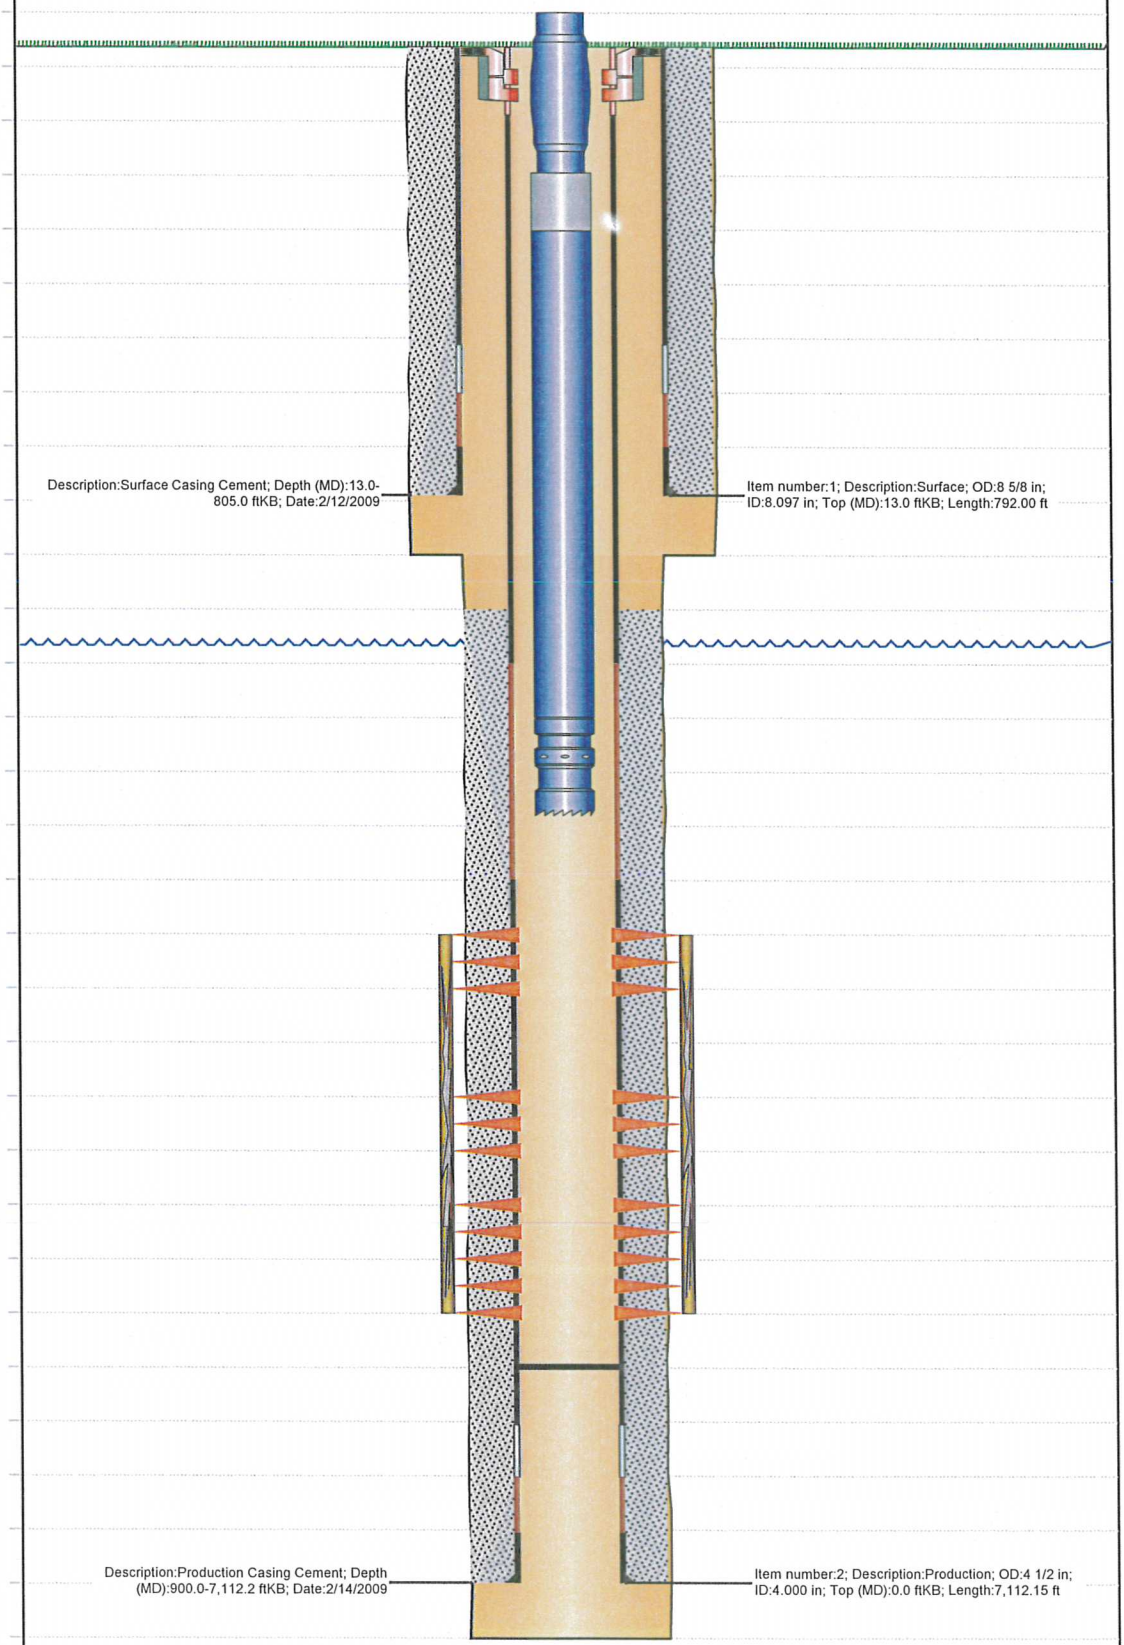

Report Printed: 9/30/2013