


Well Name: TASHIRO-UPRR 01

VERTICAL - ORIGINAL HOLE, 9/30/2013 2:15:53 PM

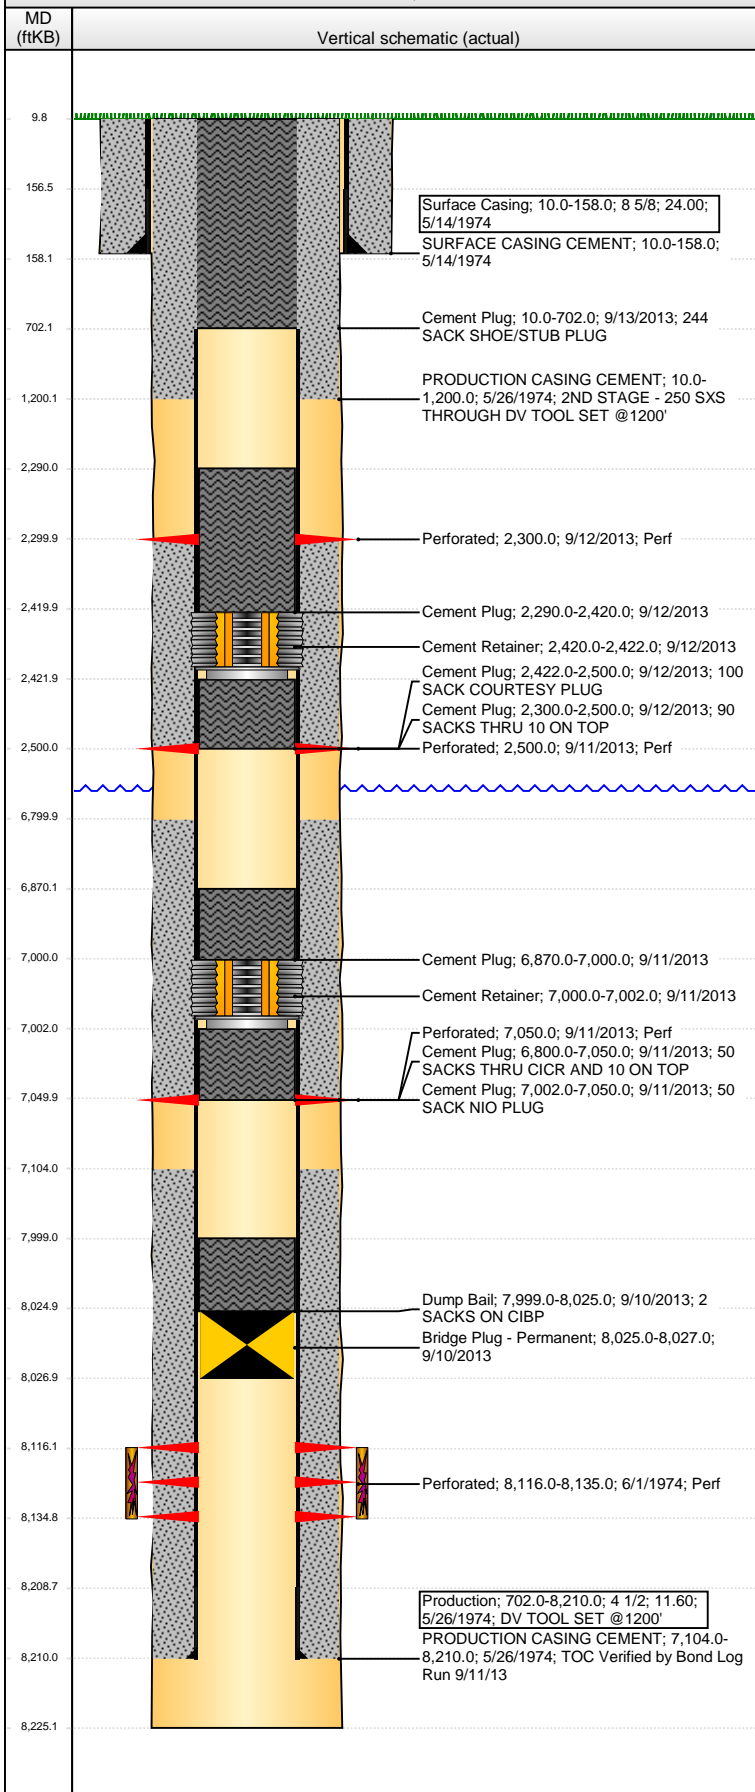

Well Header

API	Business Unit	District	Well Config
05-001-06841	WATTENBERG	15	VERTICAL
Original KB Elevation (ft)	KB - GL / MSL (ftKB)	Spud Date	P & A Date
5,039.00	10.00	5/14/1974	9/17/2013

Comment
DV TOOL SET @1200; TOC @702' verified by Bond Log Run 9/12/2013.

TOC @7104 verified by Bond Log Run 9/11/2013

Directions To Well

Congressional Location

Quarter 1	Quarter 2	Quarter 3	Quarter 4	Section	Township	Twnshp N...	Range	Rng E/W Dir
		SW	SW	17	1	S	66	W

Bottom Hole Location

North-South Distance (ft)	From N or S Line	East-West Distance (ft)	From E or W Line

Plug Back Total Depths

Date	Depth (ftKB)	Method	Com

Wellbore Sections

Section Des	Size (in)	Act Top (ftKB)	Act Btm (ftKB)
SURFACE	12 1/4	10.0	158.0
PRODUCTION	7 7/8	158.0	8,225.0

Zone Statuses

Zone Name	Status Date	Status	Job
J SAND	6/20/1974	PR	DRILLING/COMPLETION - RE-ENTRY, 5/14/1974 00:00
J SAND	9/17/2013	P&A	

Casing Strings

Surface Casing, 158.0ftKB

Casing Description	Run Date	OD (in)	Wt/Len (l...)	Grade	Top (ftKB)	MD (ftKB)
Surface Casing	5/14/1974	8 5/8	24.00		10.0	158.0

Production, 8,210.0ftKB

Casing Description	Run Date	OD (in)	Wt/Len (l...)	Grade	Top (ftKB)	MD (ftKB)
Production	5/26/1974	4 1/2	11.60		10.0	8,210.0

Cement

Description	Top Depth (ftKB)	Bottom Depth (ftKB)
SURFACE CASING CEMENT	10.0	158.0
PRODUCTION CASING CEMENT	10.0	1,200.0
PRODUCTION CASING CEMENT	7,104.0	8,210.0
Dump Bail	7,999.0	8,025.0
Cement Plug	6,800.0	7,050.0
Cement Plug	6,870.0	7,000.0
Cement Plug	7,002.0	7,050.0
Cement Plug	2,300.0	2,500.0
Cement Plug	2,290.0	2,420.0
Cement Plug	2,422.0	2,500.0
Cement Plug	10.0	702.0

Tubing Components

Item Des	OD (in)	Wt (lb/ft)	Grade	Jts	Len (ft)	Btm (ftKB)	Btm (TVD) (ftKB)

Perforation Data

Zone	Bnch/St g	Entered Shot Total	Top (ftKB)	Btm (ftKB)	Date
		2	2,300.00	2,300.00	9/12/2013
		2	2,500.00	2,500.00	9/11/2013
		2	7,050.00	7,050.00	9/11/2013
J SAND, ORIGINAL HOLE		39	8,116.00	8,135.00	6/1/1974

Well Name: TASHIRO-UPRR 01

VERTICAL - ORIGINAL HOLE, 9/30/2013 2:16:00 PM

Stimulations & Treatments

Date 6/1/1974	Zone J SAND, ORIGINAL HOLE	Primary Job Type DRILLING/COMPLETION - RE-ENTRY
Technical Result	Tech Result Details	Tech Result Note
Comment		

Other In Hole

Run Date	Des	OD (in)	Top (ftKB)	Btm (ftKB)
9/10/2013	Bridge Plug - Permanent	3.99	8,025.0	8,027.0
9/11/2013	Cement Retainer	3.99	7,000.0	7,002.0
9/12/2013	Cement Retainer	3.99	2,420.0	2,422.0

Logs

Date	Type	Top (ftKB)	Btm (ftKB)
5/25/1974	INDUCTION	158.0	8,224.0
5/25/1974	RESISTIVITY	8,080.0	8,217.0
5/26/1974	COMPENSATED DENSITY	4,750.0	8,224.0
9/10/2013	GYRO	10.0	7,500.0
9/11/2013	CBL/CCL/GR	0.0	7,990.0

