


Schneider Energy Services, Inc

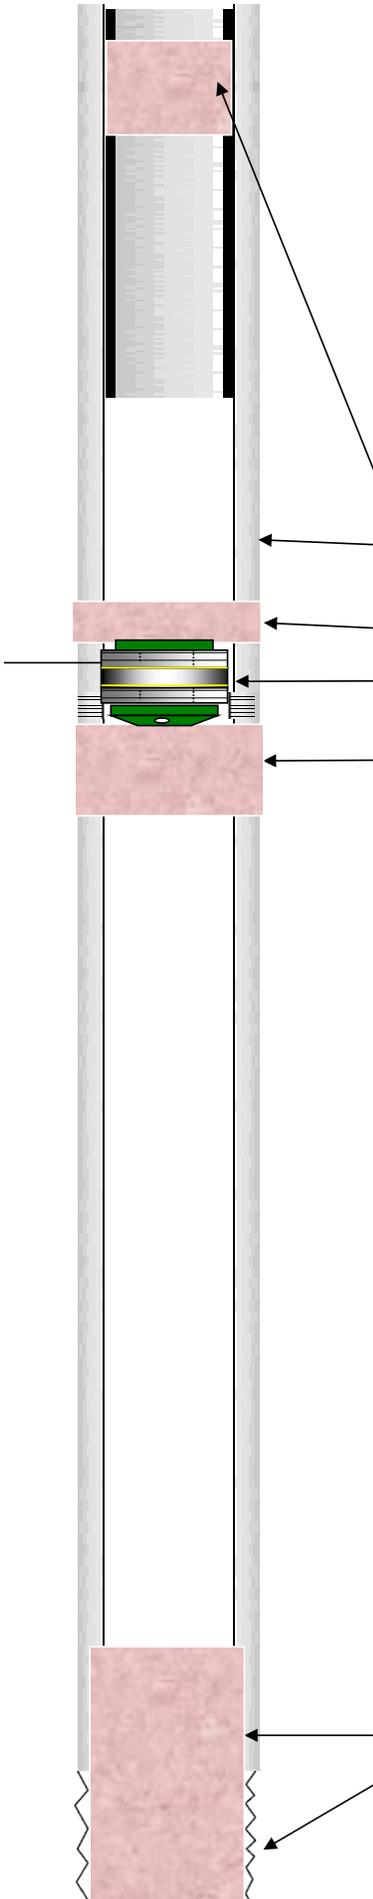

COMPANY PUBLIC SERVICES COMPANY OF COLORADO					DATE 10/09/13		
LEASE ASHBURY CREEK STORAGE UNIT #1							
CASING	Size	Weight	Grade	Thread	Depth		
		32.75	J-55		815'		
CASING	Size	Weight	Grade	Thread	Depth		
	5-1/2"	15.5	J-55	LT&C	2727'		
	First String	Size	Weight	Grade	Thread	Depth	
drill pipe							
	Second String	Size	Weight	Grade	Thread	Depth	
Prepared for:			Perforations: D-Sand - 6024' to 6030'				
ITEM No#	Length	Description			ID	OD	Depth
1	815'	35 sack cement plug from 50' to 5'					50.00
2	815'	10-3/4" Surface Casing					815'
		2 SACKS OF CEMENT					
		Cement Retainer set @ 765'					
		50 SACKS OF CEMENT					
		75 SACK CEMENT PLUG FROM 2677 TO 2882'					
		OPEN HOLE FROM 2727 TO 2882'					
PREPARED BY Jeff Schneider				PHONE:			
OFFICE 970-867-9437			PHONE		INVOICE #		