


**KERR-MCGEE OIL AND GAS ONSHORE LP**  
**FLOYD ADLER GAS UNIT C 1**  
**SW NE 33 3N 68W -- --**  
**WELD,COLORADO**  
**10/14/2013**

**AREA: S2**      **ROUTE: S23**    **Spud: 04/17/1976**    **WINS No.: 74273**    **AFE/WO#: 88415571**    **API#: 0512308678**

**GL: 4910**    **KB: 4920**    **MTD: 7879**    **TVD: 7879**    **LOG MD: 7857**    **PBMD: 7854**    **PBTVD: 7854**

**Directions:**    **WCR 28 & WCR 7, W 0.25, S 0.2 INTO, 0.1 E OF BATTERY**

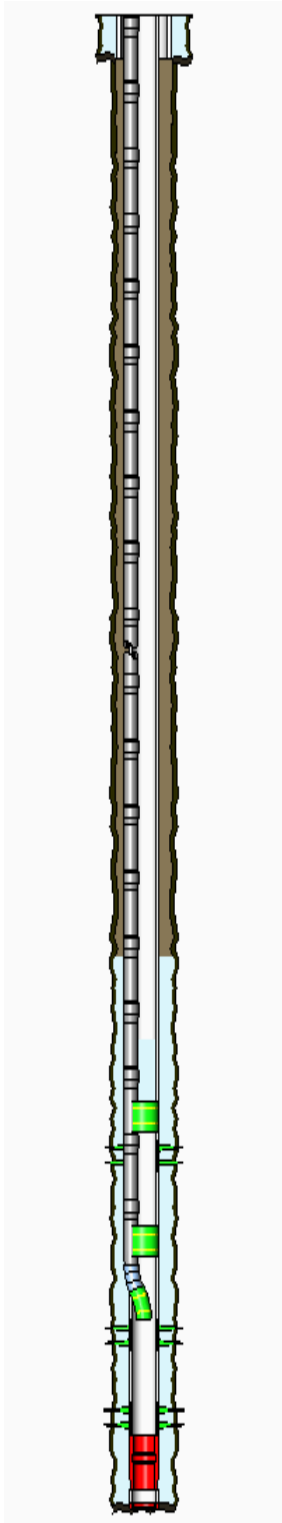

<u>HOLE SECTIONS</u>	<u>Size</u>	<u>Top</u>	<u>Btm</u>	<u>TD Date</u>
SURFACE	12.25	10	290	04/17/1976
PRODUCTION	7.88	290	7879	04/27/1976

<u>TUBULARS</u>	<u>Tool Type</u>	<u>Joints</u>	<u>Size</u>	<u>Weight</u>	<u>Grade</u>	<u>Thread</u>	<u>Top D</u>	<u>Bottom D</u>
SURFACE CASING	Casing	6	8.63	24.00	J-55	ST&C	10	285
PRODUCTION CASING	Casing	243	4.50	11.60	K-55	LT&C	10	7845
	Casing Float Collar	1	4.50				7845	7846
	Casing	1	4.50	11.60	K-55	LT&C	7846	7878
	Casing Guide Shoe	1	4.50				7878	7879
BRIDGE PLUG		1	4.50				7700	7701
BRIDGE PLUG	Cast Iron Bridge Plu	1	4.50				7061	7062
BRIDGE PLUG	Cast Iron Bridge Plu	1	4.50				7498	7499

<u>CEMENT JOBS</u>	<u>Stage</u>	<u>Sacks</u>	<u>Cement Jobs</u>	<u>Top D</u>	<u>Btm D</u>	<u>cbl</u>
SURFACE CASING	STAGE 1	250	REGULAR	10	285	No
PRODUCTION CASING	STAGE 1	650	50/50 POZ-MIX	6124	7879	Yes
PRODUCTION CASING	ABANDONMENT PLUG			6656	7056	No

<u>PERFORATIONS</u>	<u>Formation</u>	<u>Zone</u>	<u>Top</u>	<u>Btm</u>	<u>Date</u>	<u>Reason</u>	<u>Comments</u>
	CODELL		7121	7131	11/22/1995	PRODUCTION	4 SPF
	J SAND	J-Sand	7558	7580	11/30/1976	PRODUCTION	2 SPF
	LAKOTA		7832	7839	05/10/1976	PRODUCTION	4 SPF - Under BP @ 7,700'

**Comments:**