

## WELLBORE DIAGRAM


### Bayswater E & P Casa Loma 4-25

NENE Sec 26-T7N-R67W  
SHL: 527' FNL, 186' FEL  
BHL: 675' FNL, 648' FWL  
Weld County CO  
05-123-36261

Directions: CR 74 @ CR 23, 1.75 miles North, West into

Updated  
3/28/2013  
MMA

G.L.= 4954  
K.B.= 4970  
16

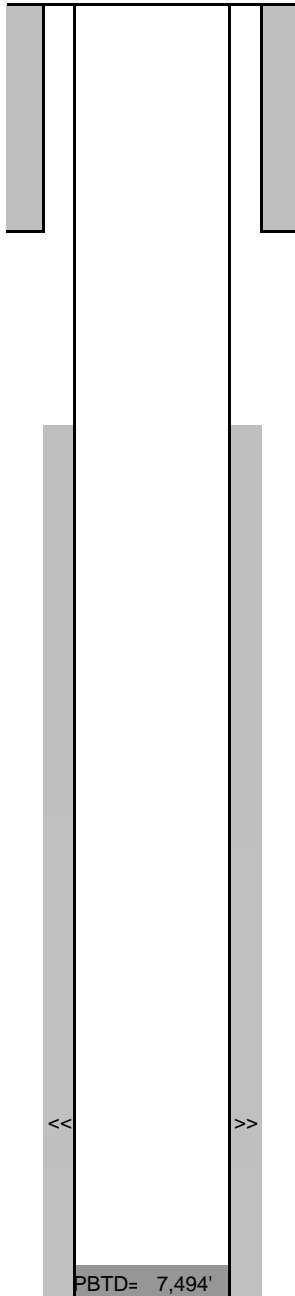

8-5/8" 24# set at 772'  
Cmt'd w/ 300 sx to Surf.

TOC: 1596'  
CBL

Codell: 7370'-7390', 4spf, 80 holes  
Frac on 3/28/2013 with 267,152 gals of slickwater and 180,960 lbs of 30/50.

4 1/2", 11.6# NW-80 LTC 7512' (7-7/8" O.H.)  
Cmt'd w/ 825 sx

PBTd= 7,494'  
TD MD= 7,525'  
TD VD= 7,441'