




DRILLING COMPANY, INC.
WICHITA, KANSAS
Wellbore Diagram

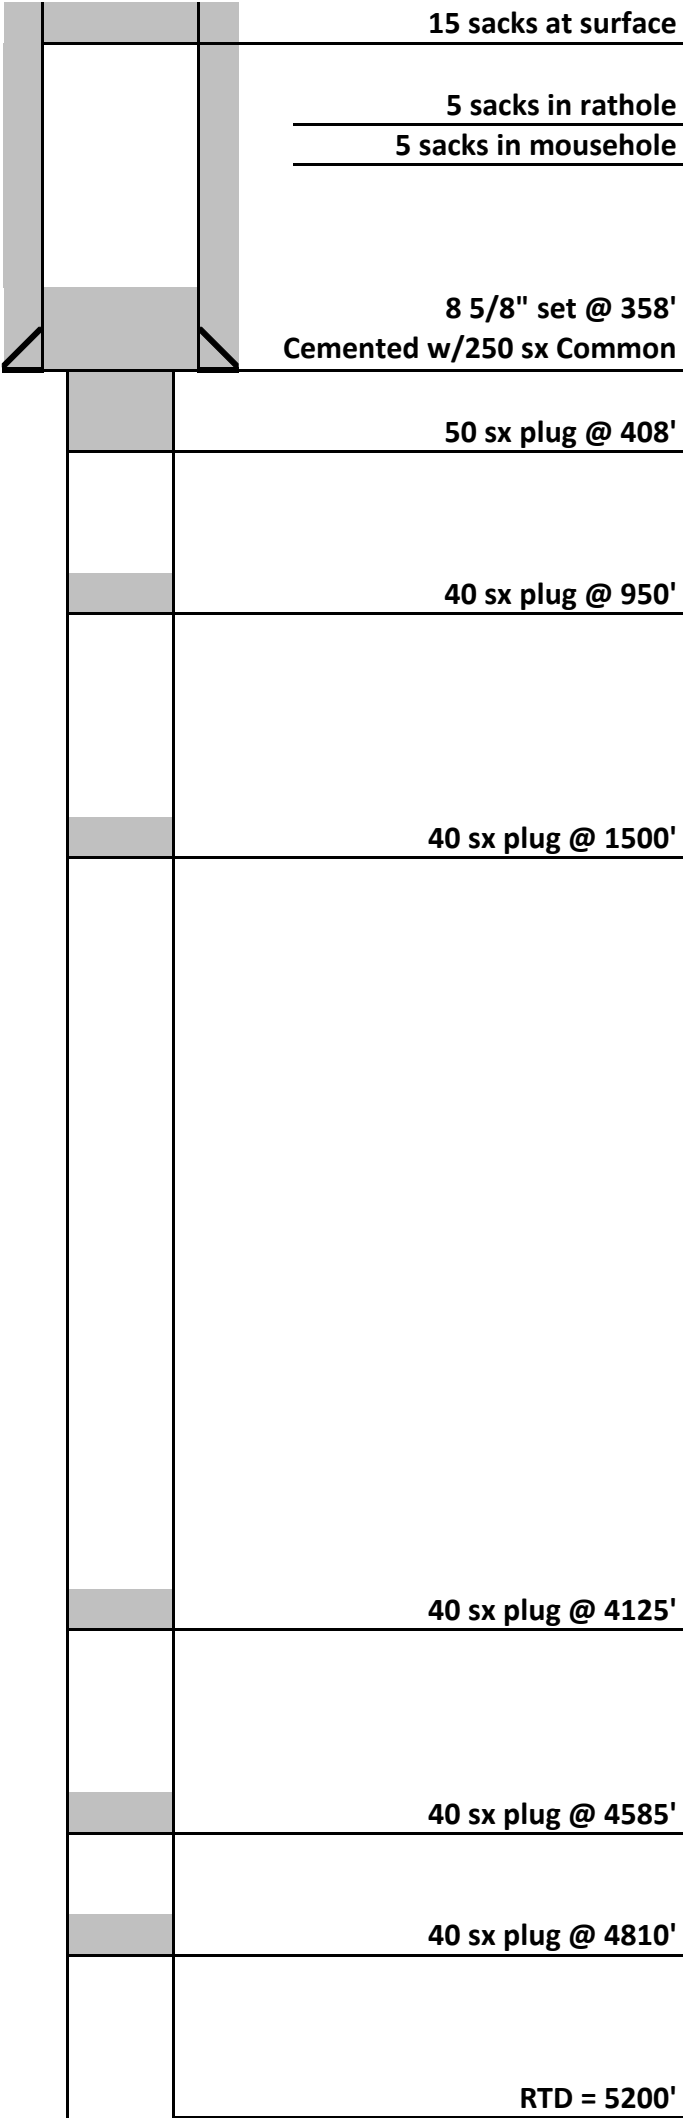

Date:	10/15/2013
Well Name:	Porky #1-32
Location:	687' FSL & 978' FEL
	SE/4 SE/4 32-17S-45W
County:	Kiowa
State:	Colorado
API:	05-061-06888-00
Surface Casing:	8 5/8" set @ 358'
Cemented with:	250 sx Common
Total Depth:	5200'
Spud Date:	9/21/2013
P&A Date:	10/3/2013

LOG TOPS	
FORMATION	DEPTH
Stone Corral	2392
Shawnee	3553
Heebner	3753
Lansing	3779
Marmaton	4172
Ft. Scott	4270
Cherokee	4328
Atoka	4486
Morrow	4635
Keyes	4809
Mississippian	4840
Spergen	5004
Harrison	5162