

**KERR-MCGEE OIL AND GAS ONSHORE LP**

**CAMENISCH PHILLIP GU #1**

**SW SW 2 1N 67W -- --**

**WELD,COLORADO**

**10/14/2013**

**AREA: S3**

**ROUTE: S33**

**Spud: 01/24/1976**

**WINS No.: 73823**

**AFE/WO#: 88368002**

**API#: 0512308600**

**GL: 5029**

**KB: 5039**

**MTD: 8240**


**TVD: 8240**

**LOG MD: 8178**

**PBMD: 8178**

**PBTVD: 8178**

**Directions: HWY 52 TO RD 21, S 1/2 MI, E&N 1/8 MI, E 1/8 MI, INTO**

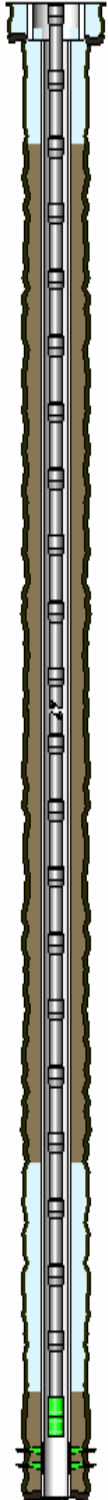

<u>HOLE SECTIONS</u>	<u>Size</u>	<u>Top</u>	<u>Btm</u>	<u>TD Date</u>
SURFACE	12.25	10	214	01/24/1976
PRODUCTION	7.88	214	8240	02/02/1976

<u>TUBULARS</u>	<u>Tool Type</u>	<u>Joints</u>	<u>Size</u>	<u>Weight</u>	<u>Grade</u>	<u>Thread</u>	<u>Top D</u>	<u>Bottom D</u>
SURFACE CASING	Casing		8.63	24			10	214
PRODUCTION CASING	Casing		4.50	11.6			214	8240
PRODUCTION TUBING	Tubing	255	2.38	4.70	J-55	External-Ups	10	8072
	XN Profile Nipple	1	2.38				8072	8073
	Notched Collar	1	2.38				8073	8073

<u>CEMENT JOBS</u>	<u>Stage</u>	<u>Sacks</u>	<u>Cement Jobs</u>	<u>Top D</u>	<u>Btm D</u>	<u>cbl</u>
SURFACE CASING	STAGE 1	200	REGULAR	10	214	No
PRODUCTION CASING	STAGE 1	325	50/50 POZ-MIX	6936	8036	No
	STAGE 2	200	50/50 POZ-MIX	150	821	No
PRODUCTION CASING	SQUEEZE JOB	125	LEAD FRESH WATER	6710	7350	No

<u>PERFORATIONS</u>	<u>Formation</u>	<u>Zone</u>	<u>Top</u>	<u>Btm</u>	<u>Date</u>	<u>Reason</u>	<u>Comments</u>
			6920	6920	05/16/2013	CEMENT SQUEEZE	
			7350	7350	05/16/2013	CEMENT SQUEEZE	
J SAND			8109	8141	02/06/1976	PRODUCTION	

**Comments:**