



STATE OF
COLORADO

Allison - DNR, Rick <rick.allison@state.co.us>

Closure on remediation project 3797?

Allison - DNR, Rick <rick.allison@state.co.us>
To: Rusty Frishmuth <rfrishmuth@billbarrettcorp.com>

Thu, Jun 27, 2013 at 3:31 PM

Rusty,

I looked through the files for Remediation Project 3797. We need a confirmation sample from the surface soil across CR72 from the tank battery where a previous sample contained a TPH concentration of 5370 mg/kg. Please see the attached figure. A soil sample should be collected and analyzed for TPH to demonstrate current conditions. I stopped by this location yesterday, and based on that inspection and the remediation file, we should be able to close the project if a confirmation sample shows that TPH concentrations have been reduced.

Please contact me with any questions.

Regards,

Rick Allison, P.G.
Environmental Protection Specialist - Northeast Colorado
Colorado Oil and Gas Conservation Commission

Phone: [970-461-2970](tel:970-461-2970)
Fax: [970-461-4781](tel:970-461-4781)
Cell: [970-623-0909](tel:970-623-0909)

On Fri, Jun 21, 2013 at 7:43 AM, Rusty Frishmuth <rfrishmuth@billbarrettcorp.com> wrote:

Rick – we recently identified that we may have an old open remediation project on a well we purchased from Texas American Resources Corporation (TARC). The project stems from a spill at the Indian Tree #1 tank battery in July 2006 (COGCC document 1395662). Per the spill entry in COGIS it looks like the spill and cleanup was closed out on December 3, 2006. However, the associated remediation project #3797 doesn't have a final resolution entry in the Correspondence Log. Can you confirm that everything got taken care of back in 2006? TARC is trying to get a bond released and they have identified this open item as something we, as the buyer of their assets, need to resolve.

Rusty Frishmuth, P.E.


Environmental Health & Safety Manager

Bill Barrett Corporation

Office: [303-312-8718](tel:303-312-8718)

Cell: [303-518-2290](tel:303-518-2290)

rfrishmuth@billbarrettcorp.com

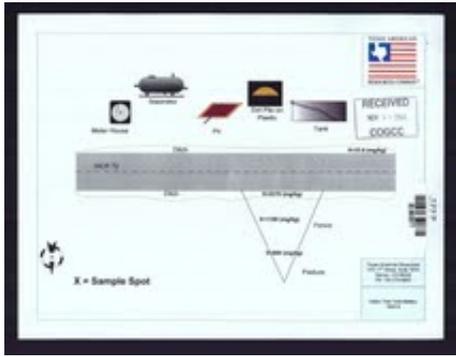

Sample Location Diagram-3797.jpg
609K