


**KERR-MCGEE OIL AND GAS ONSHORE LP**  
**CHRISTIANSEN NELS GU #1**  
**NW NE 17 2N 66W -- --**  
**WELD,COLORADO**  
**10/22/2013**

AREA: S4      ROUTE: S42    Spud: 01/06/1978    WINS No.: 75133    AFE/WO#: 2084940    API#: 0512309343

GL: 4906    KB: 4916    MTD: 8003    TVD: 8003    LOG MD: 8003    PBMD: 7951    PBTVD: 7951

Directions: HWY 85 & RD 22, E 1-6/10, S INTO

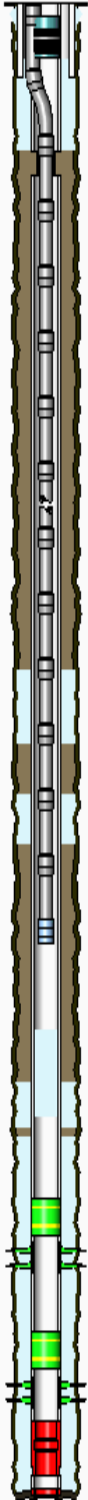

HOLE SECTIONS	Size	Top	Btm	TD Date
SURFACE	12.25	10	227	01/06/1978
PRODUCTION	7.88	10	8003	01/15/1978

TUBULARS	Tool Type	Joints	Size	Weight	Grade	Thread	Top D	Bottom D
SURFACE CASING	Casing	5	8.63	24.00			10	227
PRODUCTION CASING	Casing	17	4.50	10.50	K-55	STC	10	714
	Cement Stage Too	1					714	715
	Casing	176	4.50	10.50	K-55	STC	715	7951
	Casing Float Collar	1	4.50				7951	7953
	Casing	1	4.50	10.50	K-55	STC	7953	7998
	Casing Guide Shoe	1	4.50				7998	8000
PRODUCTION TUBING	Tubing	180	2.37	4.70	J-55	External-Ups	10	5677
	Seating Nipple	1	2.38				5677	5679
BRIDGE PLUG	CIBP With CMT Cap		4.50				7370	7371
BRIDGE PLUG	CIBP With CMT Cap		4.50				7830	7831
BRIDGE PLUG	Bridge Plug	1	4.50				96	97

CEMENT JOBS	Stage	Sacks	Cement Jobs	Top D	Btm D	cbt
SURFACE CASING	STAGE 1	200	REGULAR	10	227	No
PRODUCTION CASING	PRIM CMT 1ST STAGE	250	LEAD	6960	8003	Yes
	PRIM CMT 2ND STAGI	250	LEAD	227	650	Yes
	SQUEEZE JOB	115		6600	6900	Yes
	SQUEEZE JOB	350	LEAD-1	4006	4176	Yes
PRODUCTION CASING	SQUEEZE JOB	250	LEAD	4830	5170	Yes
--None--				0	0	No
PRODUCTION CASING	ABANDONMENT PLUC	35	LEAD FRESH WATER	6239	6830	No
PRODUCTION CASING	SQUEEZE JOB	130	LEAD FRESH WATER	4048	4500	No
	SQUEEZE JOB	38	TAIL FRESH WATER	98	703	No

PERFORATIONS	Formation	Zone	Top	Btm	Date	Reason	Comments
	SUSSEX		4150	4151	01/10/1997	CEMENT SQUEEZE	
	SUSSEX		4200	4201	08/21/2013	CEMENT SQUEEZE	
	SUSSEX		4500	4501	08/21/2013	CEMENT SQUEEZE	
	SUSSEX		4850	4851	01/09/1997	CEMENT SQUEEZE	
			6600	6900	01/25/2013	CEMENT SQUEEZE	
	CODELL		7424	7440	01/14/1997	PRODUCTION	
	J SAND		7878	7906	08/24/1978	PRODUCTION	

Comments: