WELLBORE DIAGRAM

Bonanza Creek Energy
State Antelope 14-11-28 HNB

SHL: 334' FSL & 642' FWL SWSW
Sec 28 T5N R62W
BHL: 469' FNL & 655' FWL NWNW
Sec 28 T5N R62W
Weld County, CO
05-123-36877

KB Elev	4621' ft
GL Elev	4604' ft
KB to GL	17' ft

Updated Date
6/14/2013
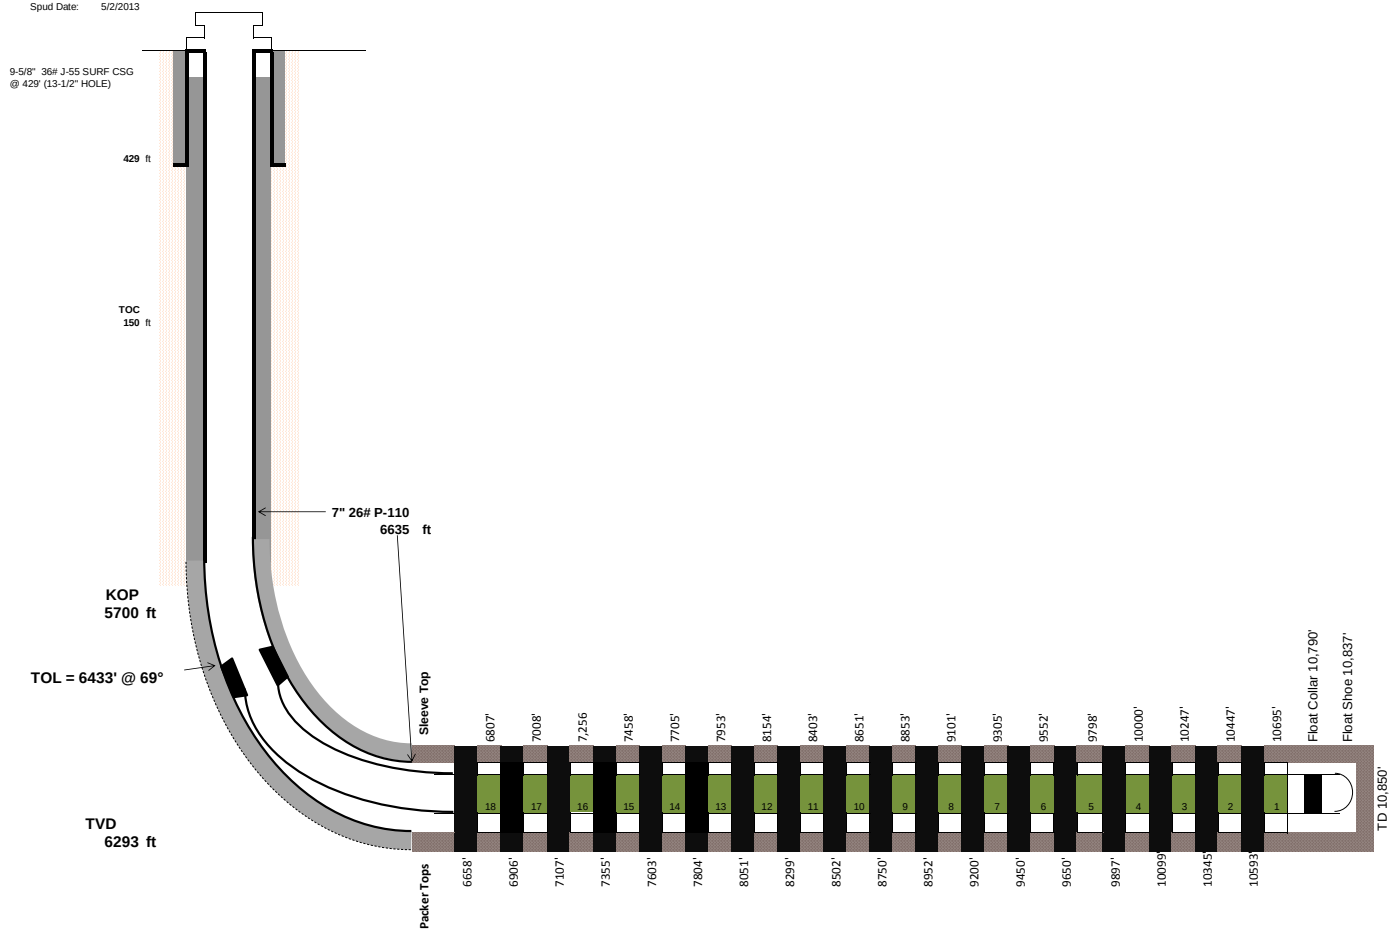
Spud Date: 5/2/2013