


**Final Well Report Detailed (graphic)**  
**Well Name: N Parachute EF14C D31 595 (D&A)**

API # 05045146620000	Well Type Gas	Business Unit Southern Rockies	SBU North Piceance	Area North Parachute	Pad D31 595	State CO	County/Parish GARFIELD
-------------------------	------------------	-----------------------------------	-----------------------	-------------------------	----------------	-------------	---------------------------

Directional - Original Hole - Initial Migration, 10/17/2013 5:24:42 AM  
 Vertical schematic (actual)

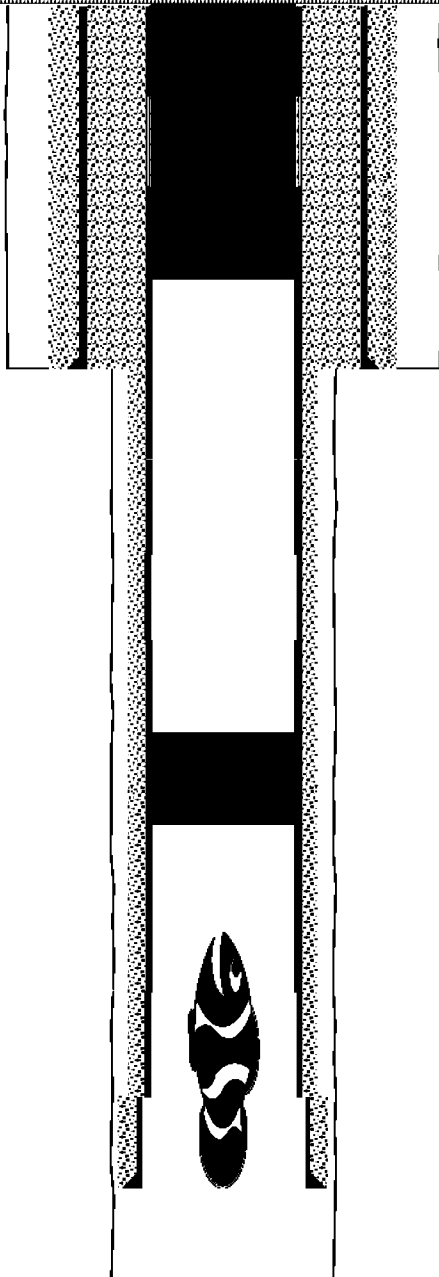

**Well Header Setup**

Well Name		API #	
N Parachute EF14C D31 595 (D&A)		05045146620000	
Original KB Elevation (ft)	Ground Elevation (ft)	Spud Date	Final Rig Relea...
5,950.00	5,928.00	11/21/2007	
Surface Legal Location	Latitude (decimal) (°)	Longitude (decimal) (°)	
	39.57436900	108.10779400	

**Wellbore Sections Setup**

Wellbore Type Original Hole - Initial Migration		Kick Off Depth (ftKB)	VS Dir (°) 145.57	
Section Des		Hole Size (in)	Act Top (ftKB)	Act Btm (ftKB)
Conductor		24	22.0	100.0
Surface		12 1/4	100.0	4,814.0

**Plug Back Total Depths**

Date	Depth (ftKB)	Method	Com

**Casing Data**

**Conductor**

Casing Description Conductor			Run Date 09/30/2007		Sel Depth (ft)KB 100.0
Item Des	OD (in)	ID (in)	Wt (lb/ft)	Grade	Len (ft)
Casing Joints	16	15.250	65.00		100.00

**Surface**

Casing Description			Run Date		Sel Depth (ftKB)
Surface			12/07/2007		4,293.0
Item Des	OD (in)	ID (in)	Wt (lb/ft)	Grade	Len (ft)
Float Shoe	8 5/8				1.72
Casing Joints	8 5/8	7.921	32.00	HC K-55	45.13
Float Collar	8 5/8				1.75
Casing Joints	8 5/8	7.921	32.00	HC K-55	761.04
Casing Joints	8 5/8	7.921	32.00	J-55	2,374.90
Other	8 5/8				2.14
Casing Joints	8 5/8	7.921	32.00	J-55	1,079.65
Other	8 5/8				5.00
Casing Joints	9 5/8				27.32

**Cement Data**

**Conductor, 100.0ftKB Proposed? No**

Description Conductor Cement		String Conductor, 100.0ftKB Proposed? No	Wellbore Original Hole - Initial Migration	Type Casing	
Stg # 1	Description Conductor		Top (ftKB) 22.0	Btm (ftKB) 100.0	Full Return?
Sequence		Fluid Des		Amount (sacks)	Class
Lead		Class H		512	

**Surface, 4,293.0ftKB Proposed? No**

Description Surface Casing Cement		String Surface, 4,293.0ftKB Proposed? No	Wellbore Original Hole - Initial Migration		Type Casing
Stg # 1	Description Surface		Top (ftKB) 22.0	Btm (ftKB) 4,293.0	Full Return?
Sequence		Fluid Des		Amount (sacks)	Class
Lead				750	
Tail				190	
Tail				150	
Lead				195	


**Surface, 4,293.0ftKB Proposed? No**

Description Cement Plug		String Surface, 4,293.0ftKB Proposed? No	Wellbore Original Hole - Initial Migration	Type Plug	
Stg # 1	Description Cement Plug		Top (ftKB) 22.0	Btm (ftKB) 60.0	Full Return?
Sequence		Fluid Des	Amount (sacks)		Class

**Final Well Report Detailed (graphic)**  
**Well Name: N Parachute EF14C D31 595 (D&A)**

API # 05045146620000	Well Type Gas	Business Unit Southern Rockies	SBU North Piceance	Area North Parachute	Pad D31 595	State CO	County/Parish GARFIELD
-------------------------	------------------	-----------------------------------	-----------------------	-------------------------	----------------	-------------	---------------------------

Directional - Original Hole - Initial Migration, 10/17/2013 5:24:43 AM  
 Vertical schematic (actual)

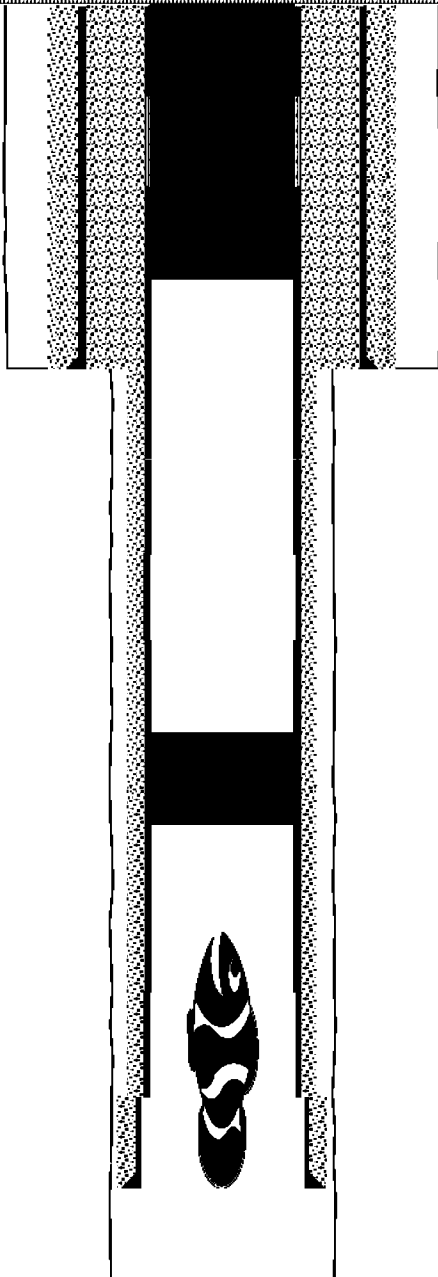

**Cement Data**

**Surface, 4,293.0ftKB Proposed? No**

Description Cement Plug		String Surface, 4,293.0ftKB Proposed? No	Wellbore Original Hole - Initial Migration		Type Plug
Stg # 2	Description Cement Plug		Top (ftKB) 4,000.0	Btm (ftKB) 4,245.0	Full Return?
Sequence		Fluid Des		Amount (sacks)	Class

**Tubing Data**

Tubing Description			Tubing Set Date	Set Depth (ftKB)
Item Des	OD (in)	ID (in)	Len (ft)	

**Rod Data**

Rod Description	Run Date	Set Depth (ftKB)
Item Des	OD (in)	Len (ft)

**Zones**

Zone Name Original Migration	Wellbore Original Hole - Initial Migration	Top Depth (ftKB)	Btm (ftKB)
Cur Stat Date	Current Status	Formation(s)	

**Perforation Data**

Stage #	Type	Top Depth (ftKB)	Bottom Depth (ftKB)	Zone
---------	------	------------------	---------------------	------

**Other In Hole**

OD (in)	Des	Top (ftKB)	Btm (ftKB)	ID (in)	Make	Model
4	Fish	4,260.0	4,293.0			

**Wellhead Description**

Install Date	Type	Make	Size (in)	WP (psi)	
Make	Model	Section	Top Sz (in)	Btm Sz (in)	WP (psi)

**Schematic Annotations**

Depth (ftKB)	Annotation
--------------	------------

**General Notes**

Date	Com
------	-----