


Final Well Report Detailed (graphic)
Well Name: N Parachute EF14C D31 595 (D&A)

API # 05045146620000	Well Type Gas	Business Unit Southern Rockies	SBU North Piceance	Area North Parachute	Pad D31 595	State CO	County/Parish GARFIELD
-------------------------	------------------	-----------------------------------	-----------------------	-------------------------	----------------	-------------	---------------------------

Directional - Original Hole - Initial Migration, 10/17/2013 5:38:37 AM
 Vertical schematic (actual)

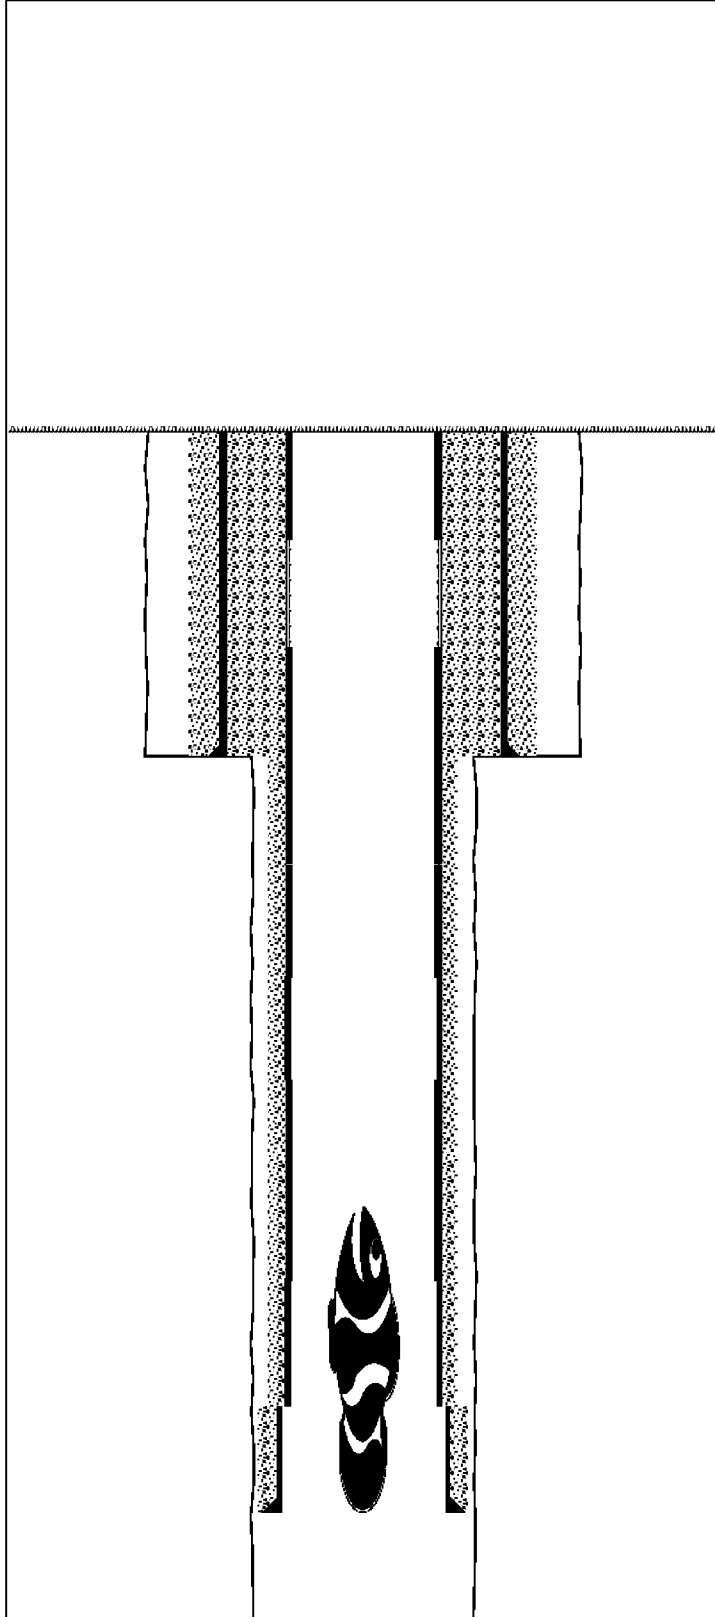

Well Header Setup

Well Name		API #	
N Parachute EF14C D31 595 (D&A)		05045146620000	
Original KB Elevation (ft)	Ground Elevation (ft)	Spud Date	Final Rig Relea...
5,950.00	5,928.00	11/21/2007	
Surface Legal Location	Latitude (decimal) (°)	Longitude (decimal) (°)	
	39.57436900	108.10779400	

Wellbore Sections Setup

Wellbore Type Original Hole - Initial Migration		Kick Off Depth (ftKB)	VS Dir (°) 145.57		
Section Des		Hole Size (in)		Act Top (ftKB)	Act Btm (ftKB)
Conductor		24		22.0	100.0
Surface		12 1/4		100.0	4,814.0

Plug Back Total Depths

Date	Depth (ftKB)	Method	Com

Casing Data

Conductor

Casing Description Conductor			Run Date 09/30/2007		Sel Depth (ft)KB 100.0
Item Des	OD (in)	ID (in)	Wt (lb/ft)	Grade	Len (ft)
Casing Joints	16	15.250	65.00		100.00

Surface

Casing Description			Run Date		Sel Depth (ftKB)
Surface			12/07/2007		4,293.0
Item Des	OD (in)	ID (in)	Wt (lb/ft)	Grade	Len (ft)
Float Shoe	8 5/8				1.72
Casing Joints	8 5/8	7.921	32.00	HC K-55	45.13
Float Collar	8 5/8				1.75
Casing Joints	8 5/8	7.921	32.00	HC K-55	761.04
Casing Joints	8 5/8	7.921	32.00	J-55	2,374.90
Other	8 5/8				2.14
Casing Joints	8 5/8	7.921	32.00	J-55	1,079.65
Other	8 5/8				5.00
Casing Joints	9 5/8				27.32

Cement Data

Conductor, 100.0ftKB Proposed? No

Description Conductor Cement		String Conductor, 100.0ftKB Proposed? No	Wellbore Original Hole - Initial Migration	Type Casing	
Stg # 1	Description Conductor		Top (ftKB) 22.0	Btm (ftKB) 100.0	Full Return?
Sequence		Fluid Des	Amount (sacks)		Class
Lead		Class H	512		

Surface, 4,293.0ftKB Proposed? No

Description Surface Casing Cement		String Surface, 4,293.0ftKB Proposed? No	Wellbore Original Hole - Initial Migration		Type Casing
Stg # 1	Description Surface		Top (ftKB) 22.0	Btm (ftKB) 4,293.0	Full Return?
Sequence		Fluid Des		Amount (sacks)	Class
Lead				750	
Tail				190	
Tail				150	
Lead				195	

Tubing Data

Tubing Description		Tubing Set Date	Set Depth (ftKB)
Item Des	OD (in)	ID (in)	Len (ft)


Rod Data

Rod Description	Run Date	Sel Depth (ftKB)

Final Well Report Detailed (graphic)
Well Name: N Parachute EF14C D31 595 (D&A)

API # 05045146620000	Well Type Gas	Business Unit Southern Rockies	SBU North Piceance	Area North Parachute	Pad D31 595	State CO	County/Parish GARFIELD
-------------------------	------------------	-----------------------------------	-----------------------	-------------------------	----------------	-------------	---------------------------

Directional - Original Hole - Initial Migration, 10/17/2013 5:38:37 AM
 Vertical schematic (actual)

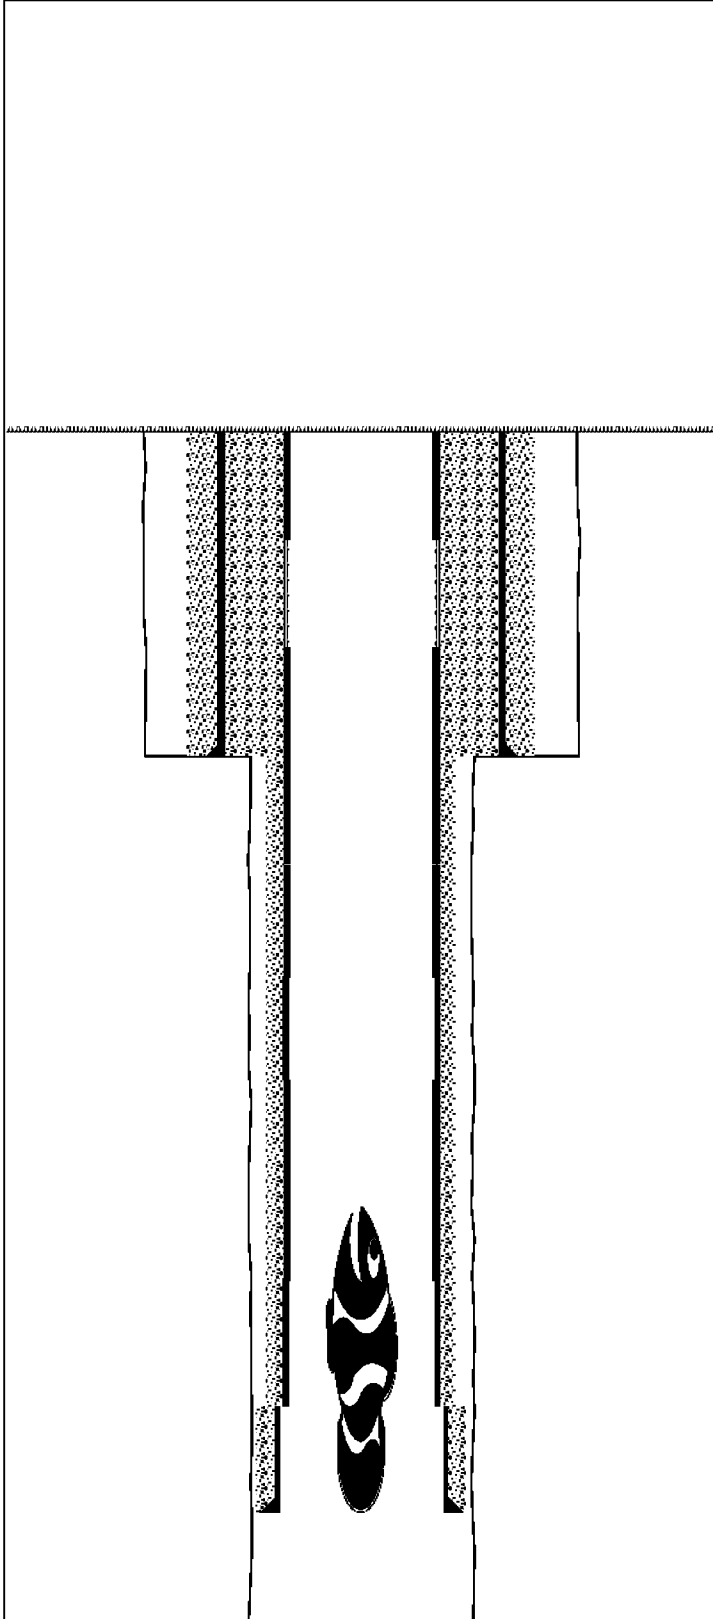

Item Des	OD (in)	Len (ft)
----------	---------	----------

Zones

Zone Name Original Migration	Wellbore Original Hole - Initial Migration	Top Depth (ftKB)	Btm (ftKB)
---------------------------------	---	------------------	------------

Cur Stat Date	Current Status	Formation(s)
---------------	----------------	--------------

Perforation Data

Stage #	Type	Top Depth (ftKB)	Bottom Depth (ftKB)	Zone
---------	------	------------------	---------------------	------

Other In Hole

OD (in)	Des	Top (ftKB)	Btm (ftKB)	ID (in)	Make	Model
4	Fish	4,260.0	4,293.0			

Wellhead Description

Install Date	Type	Make	Size (in)	WP (psi)	
Make	Model	Section	Top Sz (in)	Btm Sz (in)	WP (psi)

Schematic Annotations

Depth (ftKB)	Annotation

General Notes

Date	Com