



Baker Oil Tools

Casing Information		
7" 26# P-110		
Burst=	9,960	psi
Collapse=	6,230	psi
Capacity=	0.03826	bbbls/ft

Liner Information		
4-1/2" 11.60# HCP-110		
Burst=	10,690	psi
Collapse=	7,580	psi
Capacity=	0.01554	bbbls/ft

S-3 LINER TOP
5,620.03

Casing Shoe	KOP
6,656.00	5,710.00

Dimensional Information			
Component	OD	ID	dim
S-3	5.875	3.875	in
RE Packers	5.687	4.000	in
Sleeves	5.625	Ball Seat	in



Baker Oil Tools



FracPoint Space Out Diagram


BILL BARRETT CORPORATION WELL NUMBER: GREASEWOOD 7-17H



Displacements	BBLS	GALS
Liner Top	215.02	9,031
3.625" SLV	233.96	9,826
3.500" SLV	237.46	9,973
3.375" SLV	240.98	10,121
3.250" SLV	244.50	10,269
3.125" SLV	248.06	10,418
3.000" SLV	251.60	10,567
2.875" SLV	255.12	10,715
2.750" SLV	258.70	10,865
2.625" SLV	262.27	11,015

Displacements	BBLS	GALS
2.500" SLV	265.84	11,165
2.375" SLV	269.41	11,315
2.250" SLV	273.00	11,466
2.125" SLV	276.57	11,616
2.000" SLV	280.16	11,767
1.875" SLV	283.74	11,917
1.750" SLV	286.66	12,040
1.625" SLV	289.55	12,161
1.500 + "P" SLV	292.50	12,285
BALL SEAT	293.89	12,344
Float Shoe	294.59	12,373

Length of Zone - FT			
Zone 1	236.44	Zone 10	229.52
Zone 2	187.64	Zone 11	230.11
Zone 3	186.43	Zone 12	227.15
Zone 4	229.83	Zone 13	229.76
Zone 5	231.25	Zone 14	227.09
Zone 6	229.80	Zone 15	226.86
Zone 7	230.29	Zone 16	227.60
Zone 8	230.30	Zone 17	226.35
Zone 9	229.98	Zone 18	226.90

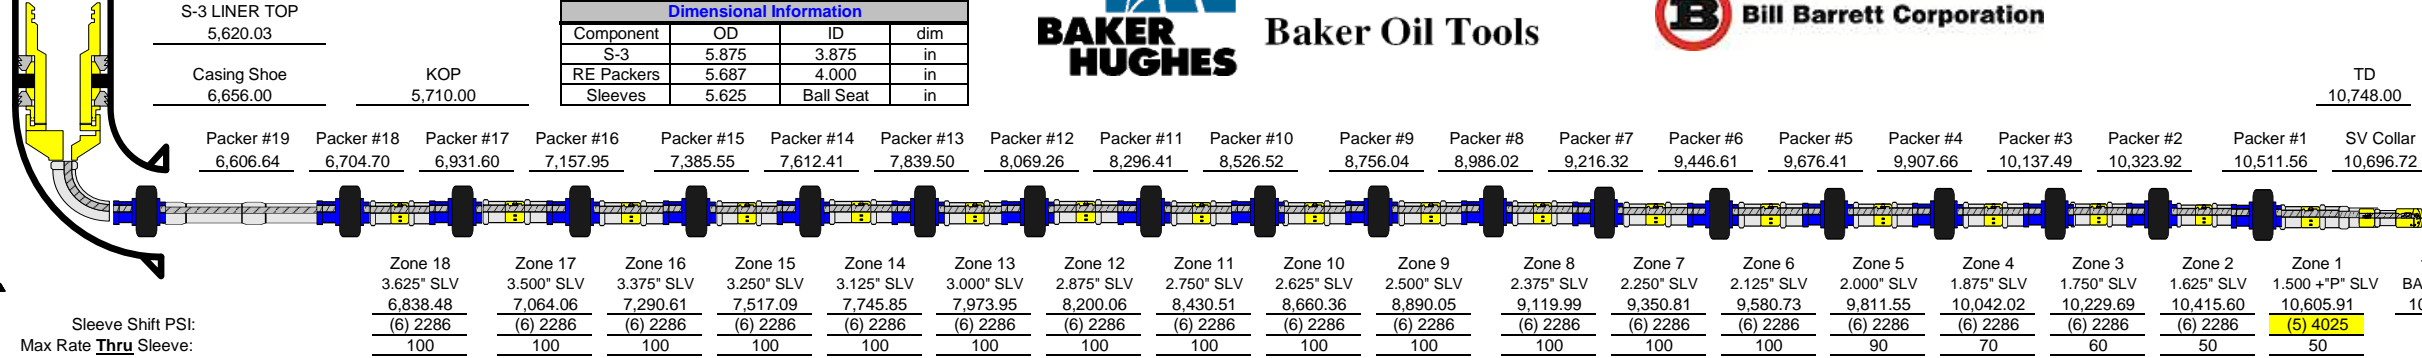

7.5.1-1F4 Frac-Point Space Out Diagram