
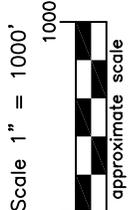


JR Land Surveying, LLC  
 8114 Northstar Drive  
 Windsor, Colorado 80528  
 P. 970-576-4641

# WELL LOCATION CERTIFICATE

*THIS MAP DOES NOT REPRESENT A BOUNDARY SURVEY*

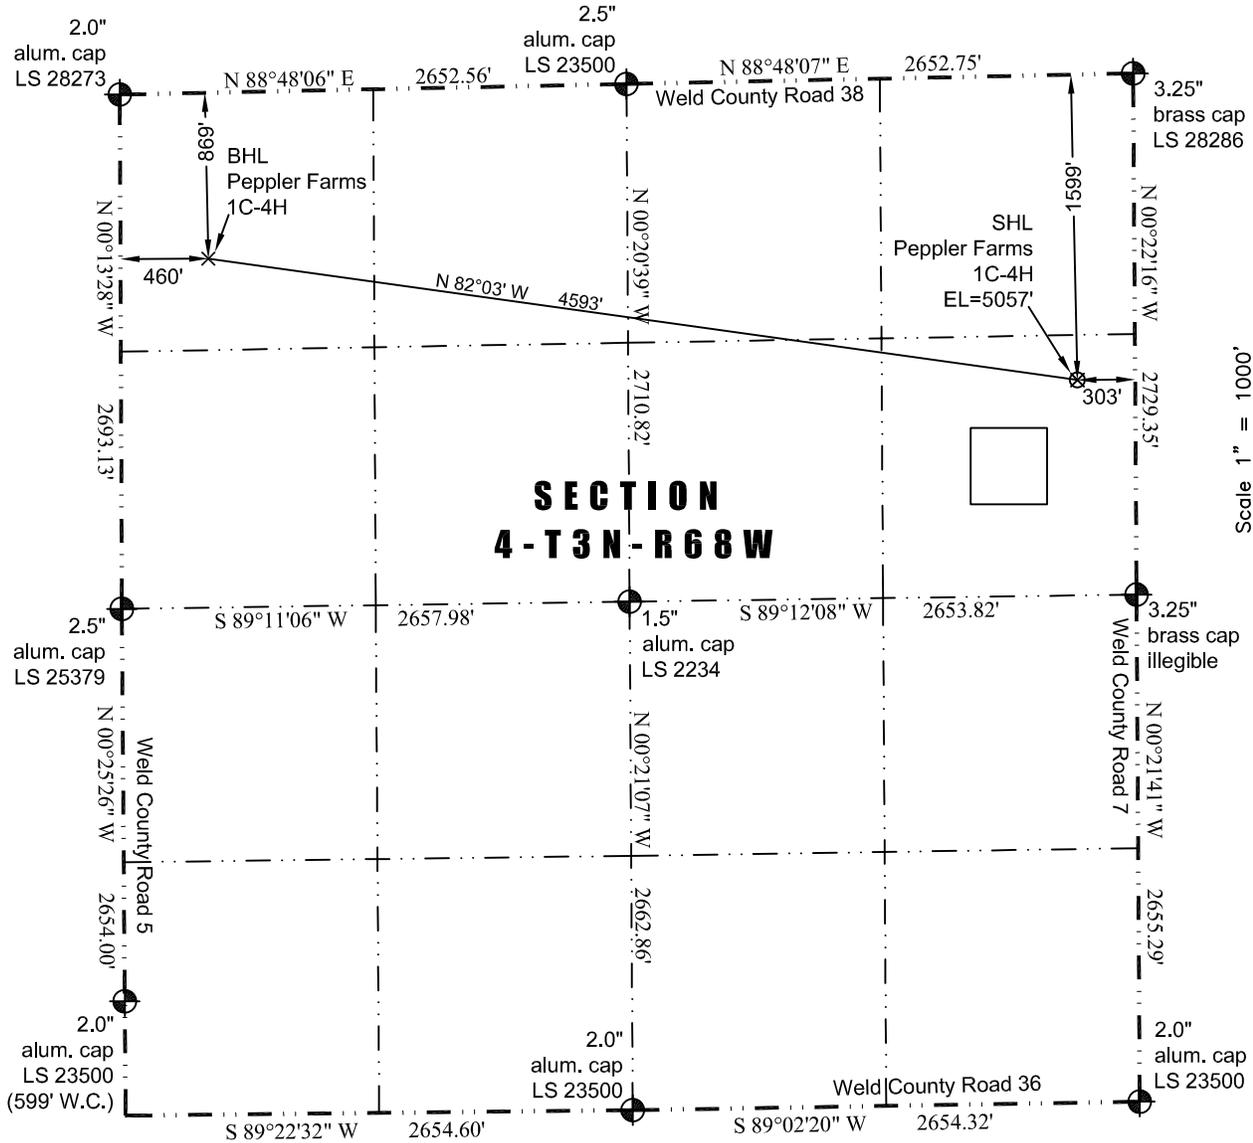

LEGEND  
 — found survey monument  
 - - - calculated dimension  
 (c)

In accordance with a request from Jay Knutson of EnCana Oil & Gas (USA) Inc., JR Land Surveying, LLC has determined the location of the **Peppler Farms 1C-4H** well site to be SHL: 1599' FNL and 303' FEL, (BHL: 869' FNL and 460' FWL), as measured at ninety (90) degrees from the section lines of Section 4, Township 3 North, Range 68 West of the 6th Principal Meridian, Weld County Colorado.


**Proposed Surface Hole Data:**  
 Latitude: N 40.25814° (BHL: 40.25995°)  
 Longitude: W 104.99976° (BHL: 105.01605°)  
 PDOP: 1.9

**Nearest:**  
 Building/Building Unit: 484' northeast      Above Ground Utility: 271' east  
 Public Road: 289' east      Railroad: +5,280'  
 Property Line: 303' east      Well Window: SHL is 297' outside  
 Existing Well: WCLI USX S 33-16, 2,282' northwest  
 High Occupancy Building Unit: +5,280'

- Notes:**
- 1) Bearings and distances based on NAD 83 Colorado North State Plane Coordinate. using RTK GPS observations taken 10/23/13 by operator John Rice.
  - 2) Conversion factor to ground (1.0002813141).
  - 3) Elevations based on NAVD 88 GPS heights and Geoid 2003 corrections.
  - 4) See Location Drawing for visible improvements within 400 feet of Pad Site.
  - 5) The surface use is a cultivated field.

**NOTICE:** According to Colorado law you must commence any legal action based upon any defect in this W.L.C. within three years after you first discover such defect. In no event may any action based upon any defect in this W.L.C. be commenced more than ten years from this said date of the certification shown hereon.

I hereby certify that this Well Location Certificate was prepared by me or under my direct supervision on 10/23/2013 for and on behalf of EnCana Oil & Gas (USA) Inc. That it is not a Land Survey Plat or an Improvement Survey Plat and that it is not to be relied upon for establishment of fences, buildings, or other future improvement lines.

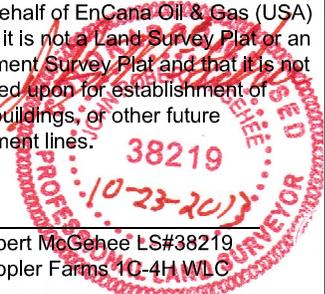

John Robert McGehee LS#38219  
 Well: Peppler Farms 1C-4H WLC