


Well Completion Diagram

API Well No: 05-075-06179-00-			
Owner:	CORAL PRODUCTION CORP		Well Name: YENTER <i>A1</i>
County:	LOGAN	Field:	YENTER Pool:
Coordinates: X	2310 FEL	Y	1067 FNL Sec: 3 Twp: 8N

Note: Changes to the drawing do not effect the database

Bore Diameters (in.)

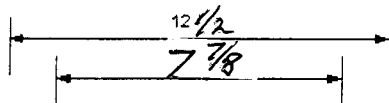

CURRENT BOREHOLE CONFIGURATION

Cement Top: 0' mthd: U

Cement Top: 0' mthd: U

8 5/8" SURF 202'

5200 4 1/2" liner
Perfs 5232-37
CIBP 5240
Perfs 5243-49
5279 PBTD
5342 5 1/2" 1st
5356 TD

