

Well

Operator

Location

County

State

Field

BILLINGS 1

EnCana Energy Resources Inc.

NENE Section 34-T2N-R68W

Weld

Colorado

Wattenberg

API:


05-123-09833-00

Spud Date

11-24-1979

Elevation: 4994'

KB: 5005'

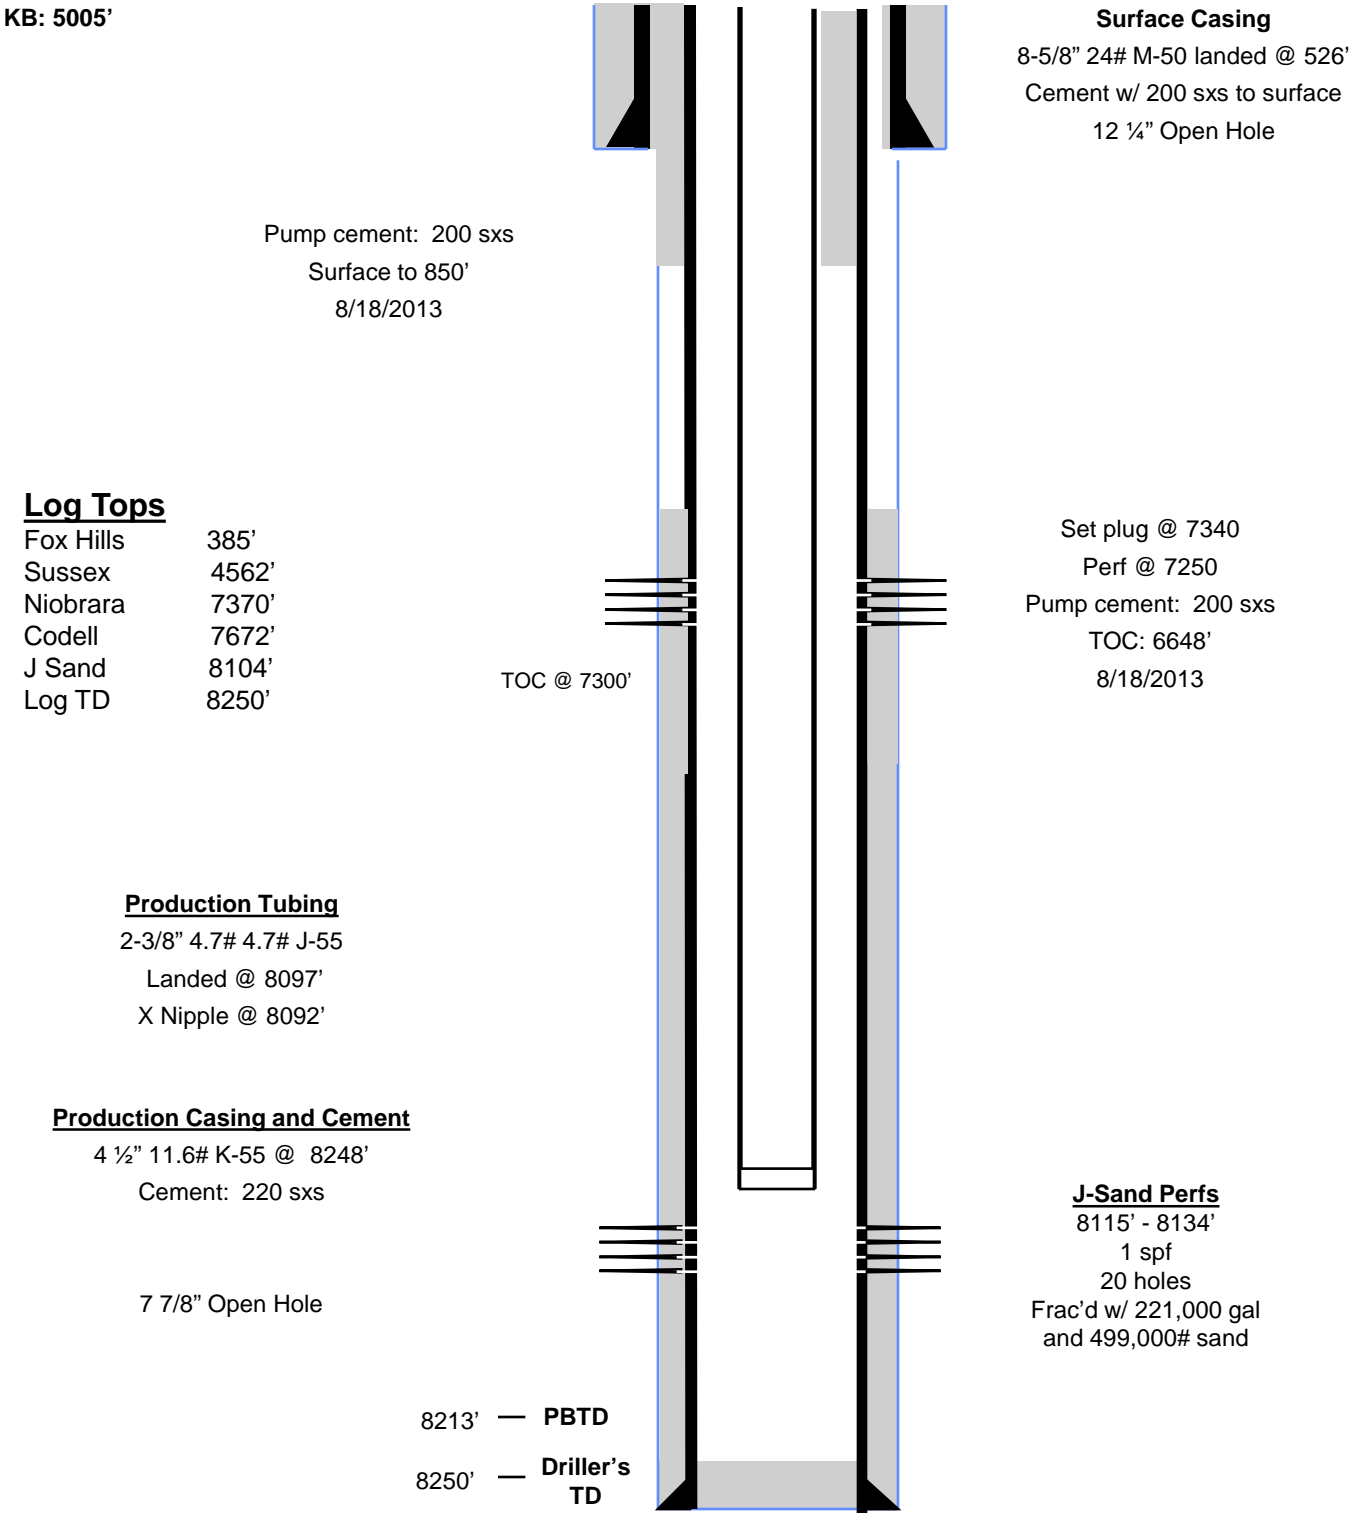

**Surface Casing**  
8-5/8" 24# M-50 landed @ 526'  
Cement w/ 200 sxs to surface  
12 1/4" Open Hole

Pump cement: 200 sxs  
Surface to 850'  
8/18/2013

**Log Tops**

Fox Hills 385'  
Sussex 4562'  
Niobrara 7370'  
Codell 7672'  
J Sand 8104'  
Log TD 8250'

Set plug @ 7340  
Perf @ 7250  
Pump cement: 200 sxs  
TOC: 6648'  
8/18/2013

**Production Tubing**

2-3/8" 4.7# 4.7# J-55  
Landed @ 8097'  
X Nipple @ 8092'

**Production Casing and Cement**

4 1/2" 11.6# K-55 @ 8248'  
Cement: 220 sxs

7 7/8" Open Hole

**J-Sand Perfs**  
8115' - 8134'  
1 spf  
20 holes  
Frac'd w/ 221,000 gal  
and 499,000# sand

8213' — PBTD  
8250' — Driller's TD