


Job # 12099 Knoss 6-21 Production Facility

Inv # 1960

High Prairie Surveying of Kiowa, Colorado has in accordance with a request from **Nighthawk Production LLC** has determined the location of the **Knoss 6-21 Production Facility** to be **51 feet FNL**, and **190 feet FWL**, (90° off Section lines) of Section **20**, Township **12s**, Range **56w** of the 6th Principal Meridian, **Lincoln County**, Colorado.

Date: Staked on 12/13/12, Drawn on 10/24/13.

Re: Staked by Elijah Frane
Drawn: Drawn by Dustin Cotter

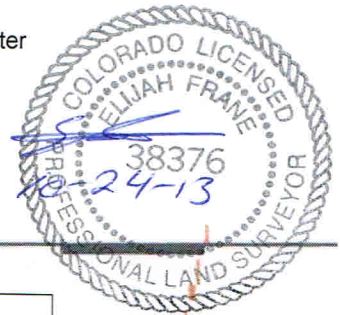

Location Drawing

An existing trail runs along the North line of the facility pad. The East R.O.W of SR 71 and a fence runs along the West line of the facility pad. The center of the facility pad is approximately 136' South of the existing trail and 138' East of the Westerly R.O.W. Line and fence.

