


Well Name: Park 42-4
County/State: Weld County, CO
SH Loc: 2053' FNL & 466' FEL, SENE Sec 4, T4N, R63W
API# 05-123-22448
AFE# 12138
Cost Center CO029105

Updated as of 2/22/2012

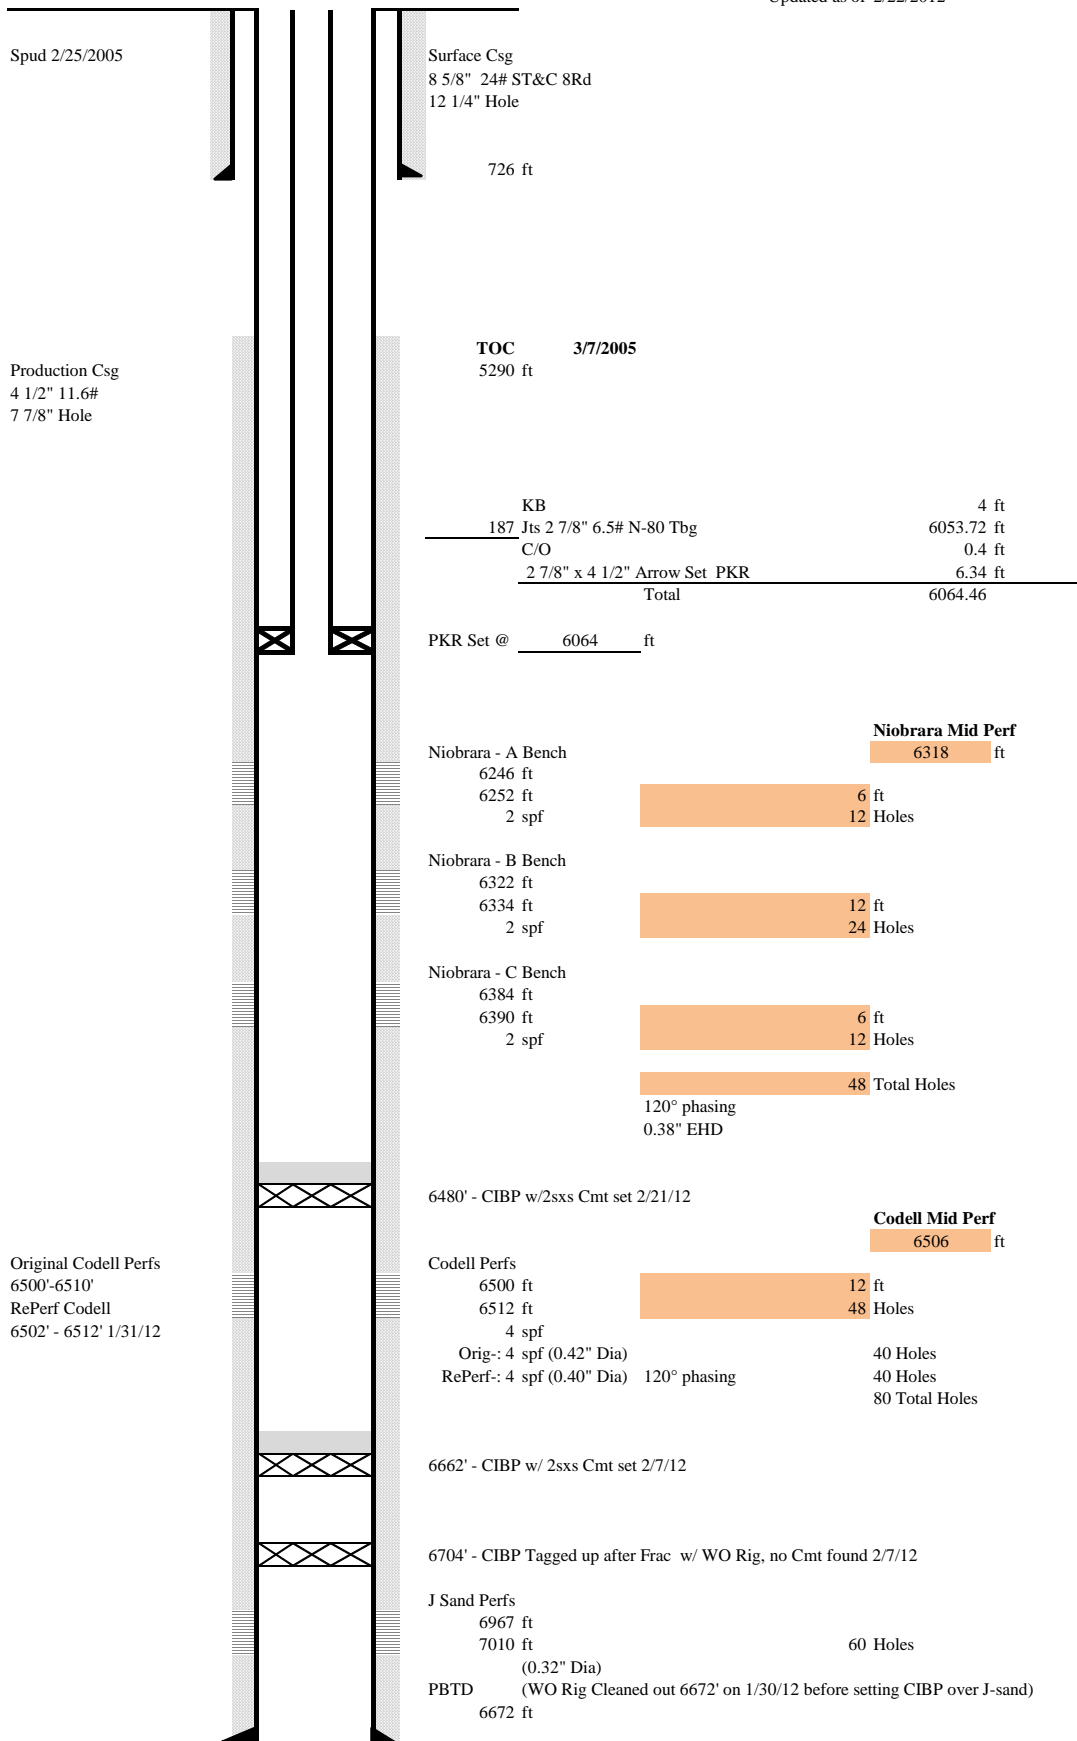

TD 7150 ft Csg Landed 7150 ft

