


SECURE
energy services

DENVER
1-866-596-1008


WILLISTON, ND
701-774-7570

WBD - Thomason 11C-3142X

Brian Peterson
Engineer - HP 311

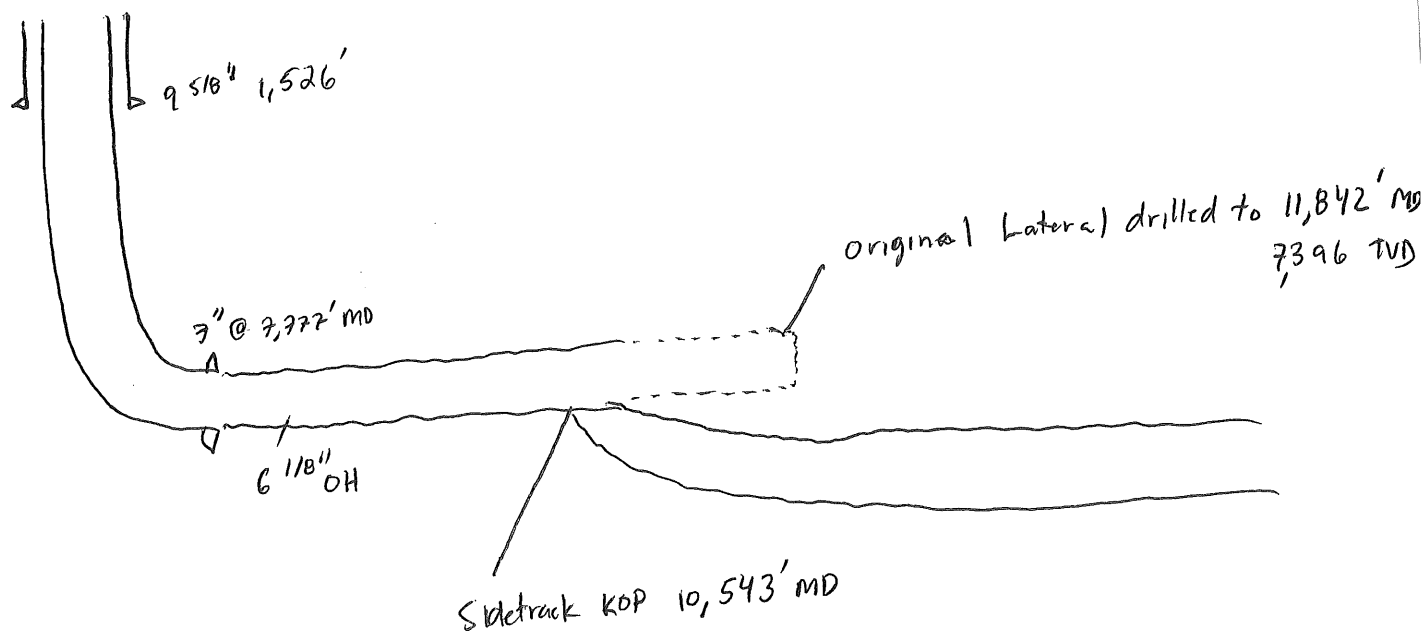

Map View

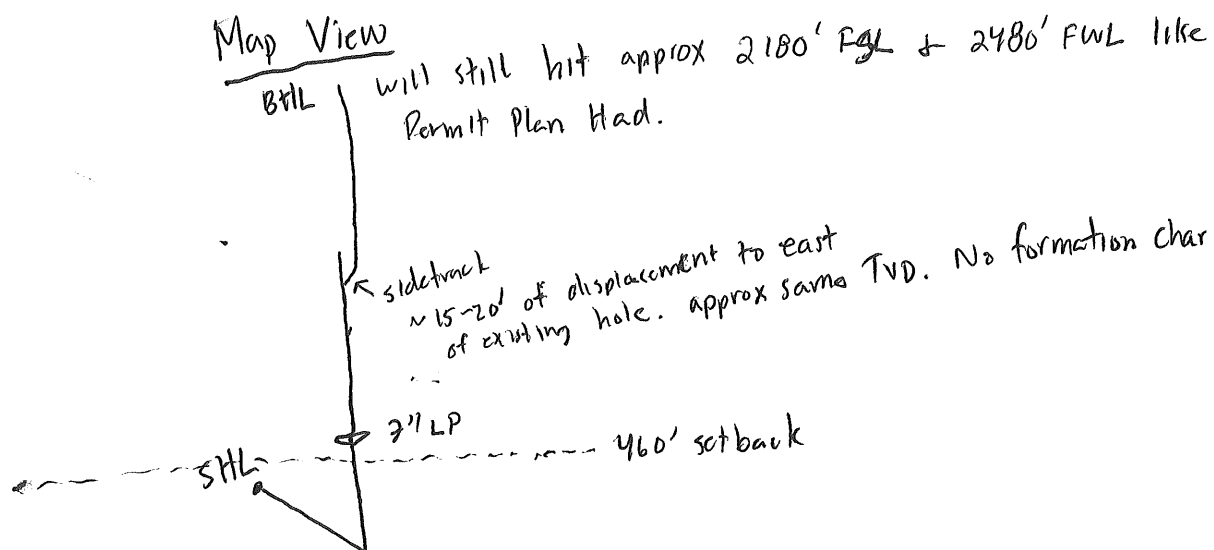

IMPERIAL DRILLING FLUIDS
970-339-9826