

**PO Box 884, Chanute, KS 66720**  
**620-431-9210 or 800-467-8676**

# FIELD TICKET & TREATMENT REPORT CEMENT

TICKET NUMBER 39334  
LOCATION Oakleafs  
FOREMAN Furzy  
OPT msl 5 5 hr

60

DATE		CUSTOMER #		WELL NAME & NUMBER		SECTION	TOWNSHIP	RANGE	COUNTY
2-13-13		3397		Sentry #1		31	20S	45W	Kiowa
CUSTOMER				SHERIDAN					
Bayhorse Petroleum				LAWRENCE					
MAILING ADDRESS				38S					
				5-2855					
				6W-					
CITY				3W					
STATE				21 1/2 W					
ZIP CODE				3W					
				21 1/2 W					
				40S					
				528					
				TRAVIS W					

JOB TYPE <u>PTA</u>	HOLE SIZE <u>7 7/8</u>	HOLE DEPTH _____	CASING SIZE & WEIGHT _____
CASING DEPTH _____	DRILL PIPE <u>4 1/2</u>	TUBING _____	OTHER _____
SLURRY WEIGHT <u>14.1</u>	SLURRY VOL <u>1.40</u>	WATER gal/sk _____	CEMENT LEFT in CASING _____
DISPLACEMENT _____	DISPLACEMENT PSI _____	MIX PSI _____	RATE _____

REMARKS: Safety meeting on Muck #20. Rip up and plus as ordered

40 sfs @ 3900'

40 gals @ 3780

55KS AN

40 GKS @ 3490'

55/25 ml

3155 Ks CLASS 'A' TOTAL

409 kg @ 3140'

40 gals @ 1100'

40 g/kg @ 500'

50543 @ 428'

155K5 Top of S. 85/8

THANKS Fuzzy & crew

[illegible]

Ravin 3737

## AUTHORIZATION

Robert W. Muckler TITLE

DATE \_\_\_\_\_

**I acknowledge that the payment terms, unless specifically amended in writing on the front of the form or in the customer's account records, at our office, and conditions of service on the back of this form are in effect for services identified on this form.**





# FIELD TICKET & TREATMENT REPORT

## CEMENT

TICKET NUMBER 39265  
LOCATION Oakley KS  
FOREMAN Kelly G9601

DATE	CUSTOMER #	WELL NAME & NUMBER	SECTION	TOWNSHIP	RANGE	COUNTY
2-3-13	3397	Sentinel #1	31	205	415W	Kiowa
CUSTOMER			Shorland			
Bayhorse Petro.			+ 3855CT			
MAILING ADDRESS			TRUCK #	DRIVER	TRUCK #	DRIVER
			405	Damon		
			530	Mike		
CITY	STATE	ZIP CODE	2 1/2 W 31 N			
			2 1/2 W 31 N into			

JOB TYPE <u>Surface</u>	HOLE SIZE <u>12 1/4</u>	HOLE DEPTH <u>392</u>	CASING SIZE & WEIGHT <u>8 5/8 24#</u>
CASING DEPTH <u>392</u>	DRILL PIPE _____	TUBING _____	OTHER _____
SLURRY WEIGHT <u>148</u>	SLURRY VOL _____	WATER gal/sk _____	CEMENT LEFT in CASING <u>20'</u>
DISPLACEMENT <u>23 1/2</u>	DISPLACEMENT PSI _____	MIX PSI _____	RATE _____

REMARKS: safety meeting, rigged up an Muffin #20, hooked up to circulate, mixed 275 SKS com 390 cc 290 gal. released plug & displaced with 23 1/2 bbl water. shut in washed out pumps & lines rigged down

Cement did circulate

Approx 46bl top of

Thank you &  
Kelly & crew

ACCOUNT CODE	QUANTITY or UNITS	DESCRIPTION of SERVICES or PRODUCT	UNIT PRICE	TOTAL
54015	1	PUMP CHARGE	1085 <sup>00</sup>	1085 <sup>00</sup>
5406	80m	MILEAGE	5 <sup>00</sup>	400 <sup>00</sup>
11045	275 SKS	Class A Cement	17 <sup>65</sup>	4853 <sup>75</sup>
1102	775#	Calcium chloride	.89	689 <sup>00</sup>
1118B	517#	Bentonite	.25	129 <sup>25</sup>
5407A	12.92	Ton mileage delivery	1 <sup>61</sup>	17 <sup>61</sup>
4432	1	8 5/8 Wooden Plug	96 <sup>00</sup>	96 <sup>00</sup>
1111	100#	salt		NC
				8980 <sup>50</sup>
		Less 10% disc		898 <sup>05</sup>
				8,082 <sup>48</sup>
			SALES TAX	
			ESTIMATED	
			TOTAL	

Bavin 3737

9:00 AM

## AUTHORIZTION


**TITLE**

DATE 4-3-73

**I acknowledge that the payment terms, unless specifically amended in writing on the front of the form or in the customer's account records, at our office, and conditions of service on the back of this form are in effect for services identified on this form.**



KIOWA COUNTY  
BAYHORSE SENTINEL #1  
SEC 31-T20S-R45W

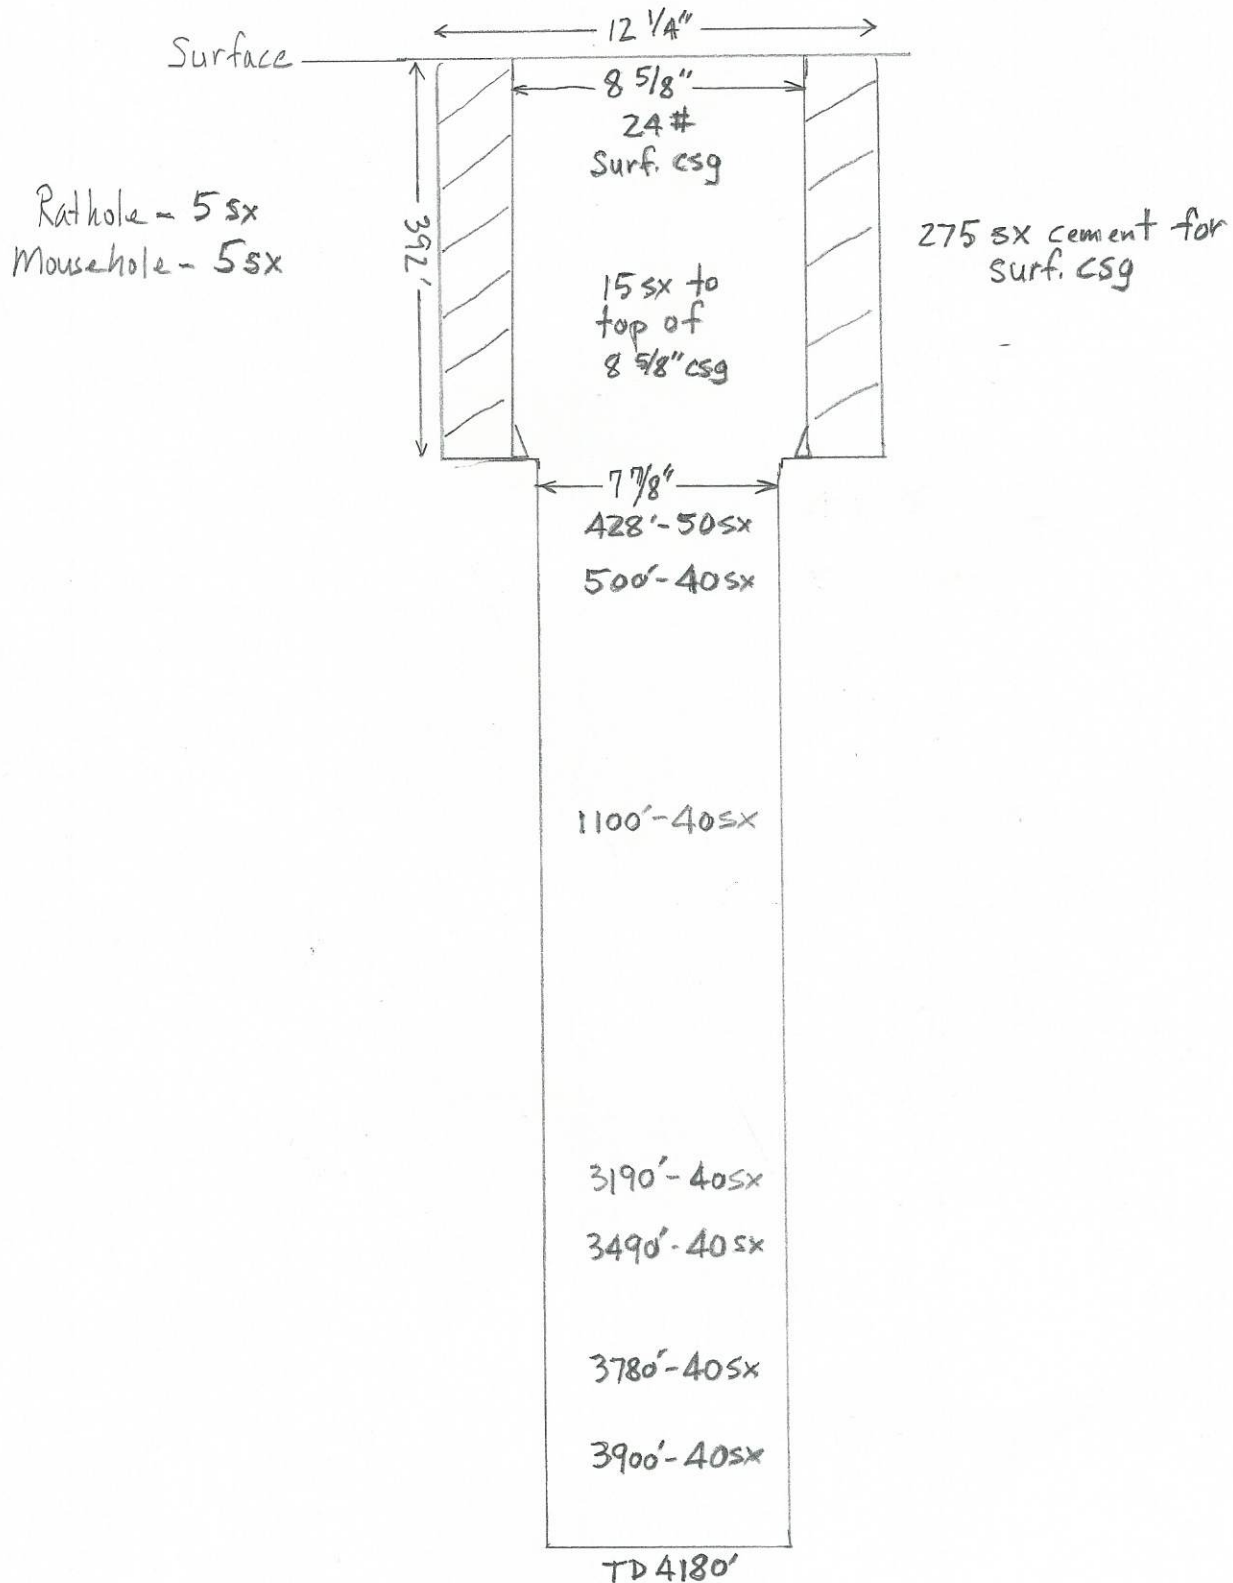

Per email Oct 25, 2013  
to: larry.coler@state.co.us