

KERR-MCGEE OIL AND GAS ONSHORE LP

MILLER, ELTON N C 2

NE SE 7 2N 66W -- --

WELD,COLORADO

10/23/2013

AREA: S1

ROUTE: S16 Spud: 07/17/1980

WINS No.: 75092

AFE/WO#: 88412772

API#: 0512309991

GL: 4853

KB: 4863

MTD: 7980


TVD: 7980

LOG MD: 7976

PBMD: 7935

PBTVD: 7935

Directions: HWY 85 & RD 22 1/2, W TO RD 25 1/2, S 1/4 MILE, W TO LOCATION

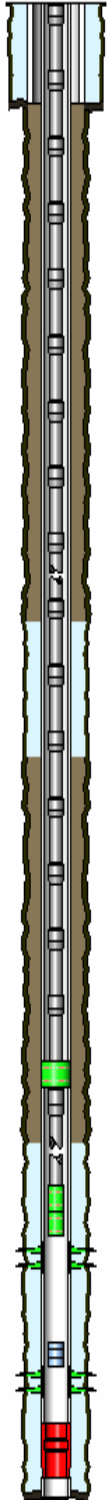

<u>HOLE SECTIONS</u>	<u>Size</u>	<u>Top</u>	<u>Btm</u>	<u>TD Date</u>				
SURFACE	12.25	10	650	07/18/1980				
PRODUCTION	7.88	650	7980	07/25/1980				
<u>TUBULARS</u>	<u>Tool Type</u>	<u>Joints</u>	<u>Size</u>	<u>Weight</u>	<u>Grade</u>	<u>Thread</u>	<u>Top D</u>	<u>Bottom D</u>
SURFACE CASING	Casing	16	8.63	24			10	642
PRODUCTION CASING	Casing	203	4.50	10.50	K-55		10	7939
	Casing Float Collar	1	4.50				7939	7940
	Casing	1	4.50	11.60	K-55		7940	7980
PRODUCTION TUBING	Tubing	253	2.38	4.7	J-55	8RD EUE	10	7802
	Seating Nipple	1	2.38				7802	7803
PRODUCTION TUBING	Tubing	210	2.38	4.70	L-80	8RD EUE	10	6672
	Retrievable Flow Th	1	4.50				6672	6678
	Tubing	20	2.38				6678	7309
	XN Profile Nipple	1	2.38				7309	7310
	Notched Collar	1	2.38				7310	7311
<u>CEMENT JOBS</u>	<u>Stage</u>	<u>Sacks</u>	<u>Cement Jobs</u>		<u>Top D</u>	<u>Btm D</u>	<u>cbl</u>	
SURFACE CASING	STAGE 1	400	REGULAR		10	642	No	
PRODUCTION CASING	SQUEEZE 1 TAIL				3900	4760	Yes	
	SQUEEZE 1				3900	4760	Yes	
	SQUEEZE 2	30	G		3900	4760	Yes	
	STAGE 1				7030	7980	Yes	
PRODUCTION CASING					0	0	No	
PRODUCTION CASING					0	0	No	
<u>PERFORATIONS</u>	<u>Formation</u>	<u>Zone</u>	<u>Top</u>	<u>Btm</u>	<u>Date</u>	<u>Reason</u>	<u>Comments</u>	
	CODELL		7349	7368	05/19/1995	PRODUCTION		
	J SAND		7808	7852	12/22/1980	PRODUCTION		

Comments: