


WELL NAME: Ehmke #1
OPERATOR: McKnab II - 55910
COMP ZONE: J Sand
LOCATION: 10N 59W S6 NWNW

COUNTY: Weld
STATE: Colorado
API : 05-123-05006

SPUD: 10/11/57
P&A: 10/24/57
GL: 5,407'

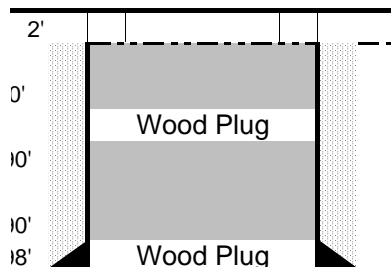

SURFACE CASING

DEPTH: 298' SIZE: 8 5/8" GRADE: Unk WT (#/ft): 14.0
CEMENT: Unknown
COMMENTS: _____

PRODUCTION CASING

DEPTH: _____ SIZE: _____ GRADE: _____ WT (#/ft): _____
CEMENT: _____ TOC: _____
COMMENTS: _____

PERFS: _____ - _____ PROD ZONE 1: _____
PERFS: _____ - _____ ZONE 2: _____
PERFS: _____ - _____ ZONE 3: _____

PLUGGING REPORT

ZONE 1 CIBP: _____ CMT: _____ OTHER: _____
2 CIBP: _____ CMT: _____ OTHER: _____
3 CIBP: _____ CMT: _____ OTHER: _____

RECOVERED: _____ SIZE: _____
CMT 1: 290' - 190' COMMENT: 30 sk cement plug + wood plug
CMT 2: 40' - 2' COMMENT: 15 sk cement plug + wood plug
CMT 3: _____ - _____ COMMENT: _____

OTHER: _____

FORMATIONS:

NIOBRARA: 6,561'
CARLILE 6,928'
D SAND: 7,345'
J SAND: 7,454'

7,527'