



Company: Great Western Operating Company, LLC

Well name: Clyde E. Williams Jr. #2

Legals: 660FEL-1980FNL-34-T2S-R64W


Event: ORIG COMPLETION

Project: DJ Basin

API no.: 05-001-07733

County: Adams

Elevation: 5,378ft

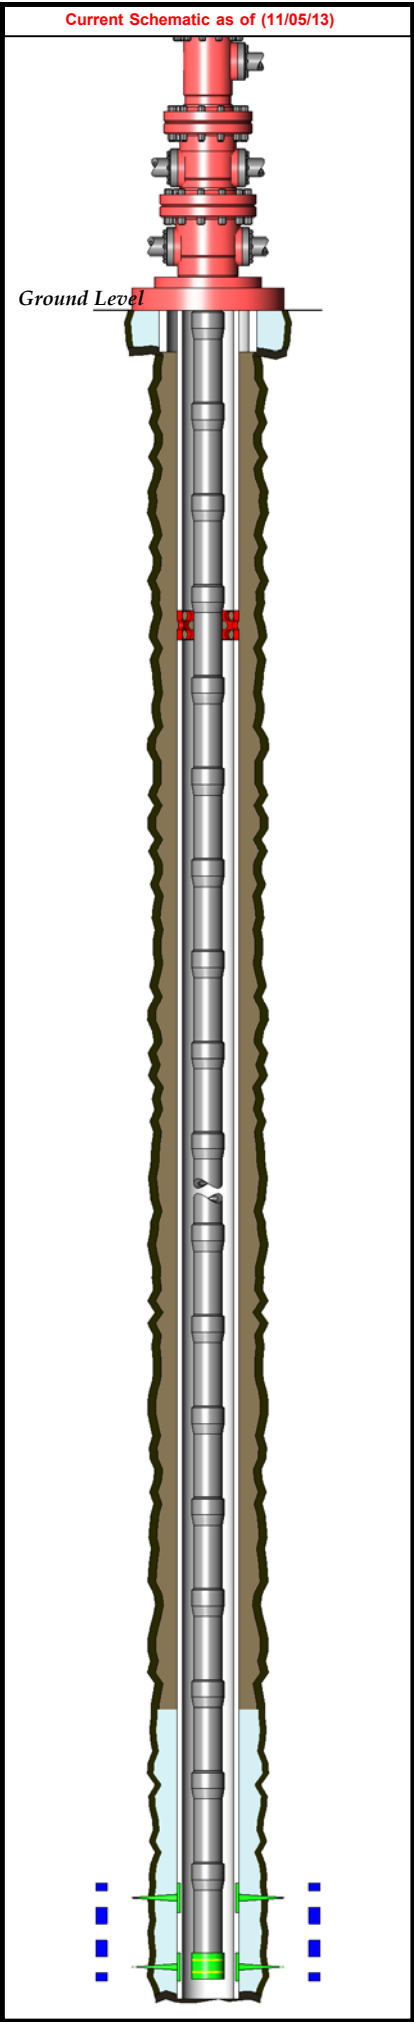

Hole	Top MD (ft)	Base MD (ft)
Surface	0	210
Produciton	210	8,100

Comp Group	Top size (in)
SURFACE CASING HEAD	8.625
CASING SPOOL	5.500
ADAPTER, TUBING HEAD	2.875

Surface		
Type	Length (ft)	Hole Size (in)
Open Hole	210	12.250

Produciton		
Type	Length (ft)	Hole Size (in)
Open Hole	7,890	7.875

Name	Top MD (ft)	Base MD (ft)
SURFACE CASING	0	210
PRODUCTION CASING #1	0	8,100

Cement Job Type: Primary			
Assembly Size	TOC (ft)	MD base (ft)	Type
8.625	0	210	250 SX

Cement Job Type: Primary			
Assembly Size	TOC (ft)	MD base (ft)	Type
5.500	7,026	8,100	200 SX

MD Top (ft)	Name
1,640	Fox Hills Base
4,765	Sussex
7,120	Niobrara
7,540	Codell
7,916	D-Sand
7,997	J-Sand

PERFORATED				
Top MD (ft)	Base MD (ft)	Date	Status	Comments
7,918	7,944	5/8/1981	OPEN	4 JSPF, 0.41

PERFORATED				
Top MD (ft)	Base MD (ft)	Date	Status	Comments
8,000	8,014	5/8/1981	OPEN	4 JSPF, 0.41

FRACTURE TREATMENT		
Top MD (ft)	Base MD (ft)	Description
8,000	8,014	43,500# 20/40 x 524 BO x 840 BW

FRACTURE TREATMENT		
Top MD (ft)	Base MD (ft)	Description
7,918	7,944	196,000# x Appollo 3,281 BW

ROD STRING							
Component	Joints	Top MD (ft)	Length (ft)	OD (in)	Grade	Weight (ppf)	Drift (in)
Rod	130	0	4,000	0.875			

TUBING ASSEMBLY #1							
Component	Joints	Top MD (ft)	Length (ft)	OD (in)	Grade	Weight (ppf)	Drift (in)
Tubing	178	0	8,000	2.875		6.50	2.344
Anchor?	1	8,000	5	2.875			

SURFACE CASING									
Component	Joints	Top MD (ft)	Length (ft)	OD (in)	Weight (ppf)	Connection	Grade	Body ID (in)	Drift (in)
Casing	5	0	210	8.625	24.0			8.094	7.969

PRODUCTION CASING #1									
Component	Joints	Top MD (ft)	Length (ft)	OD (in)	Weight (ppf)	Connection	Grade	Body ID (in)	Drift (in)
Casing	37	0	1,537	5.500	17.0			4.938	4.781
DV Tool	1	1,537	6	5.500					
Casing	156	1,543	6,557	5.500	15.5			4.906	4.813