


SECTION 35

SECTION 36

PICADILLY RD.

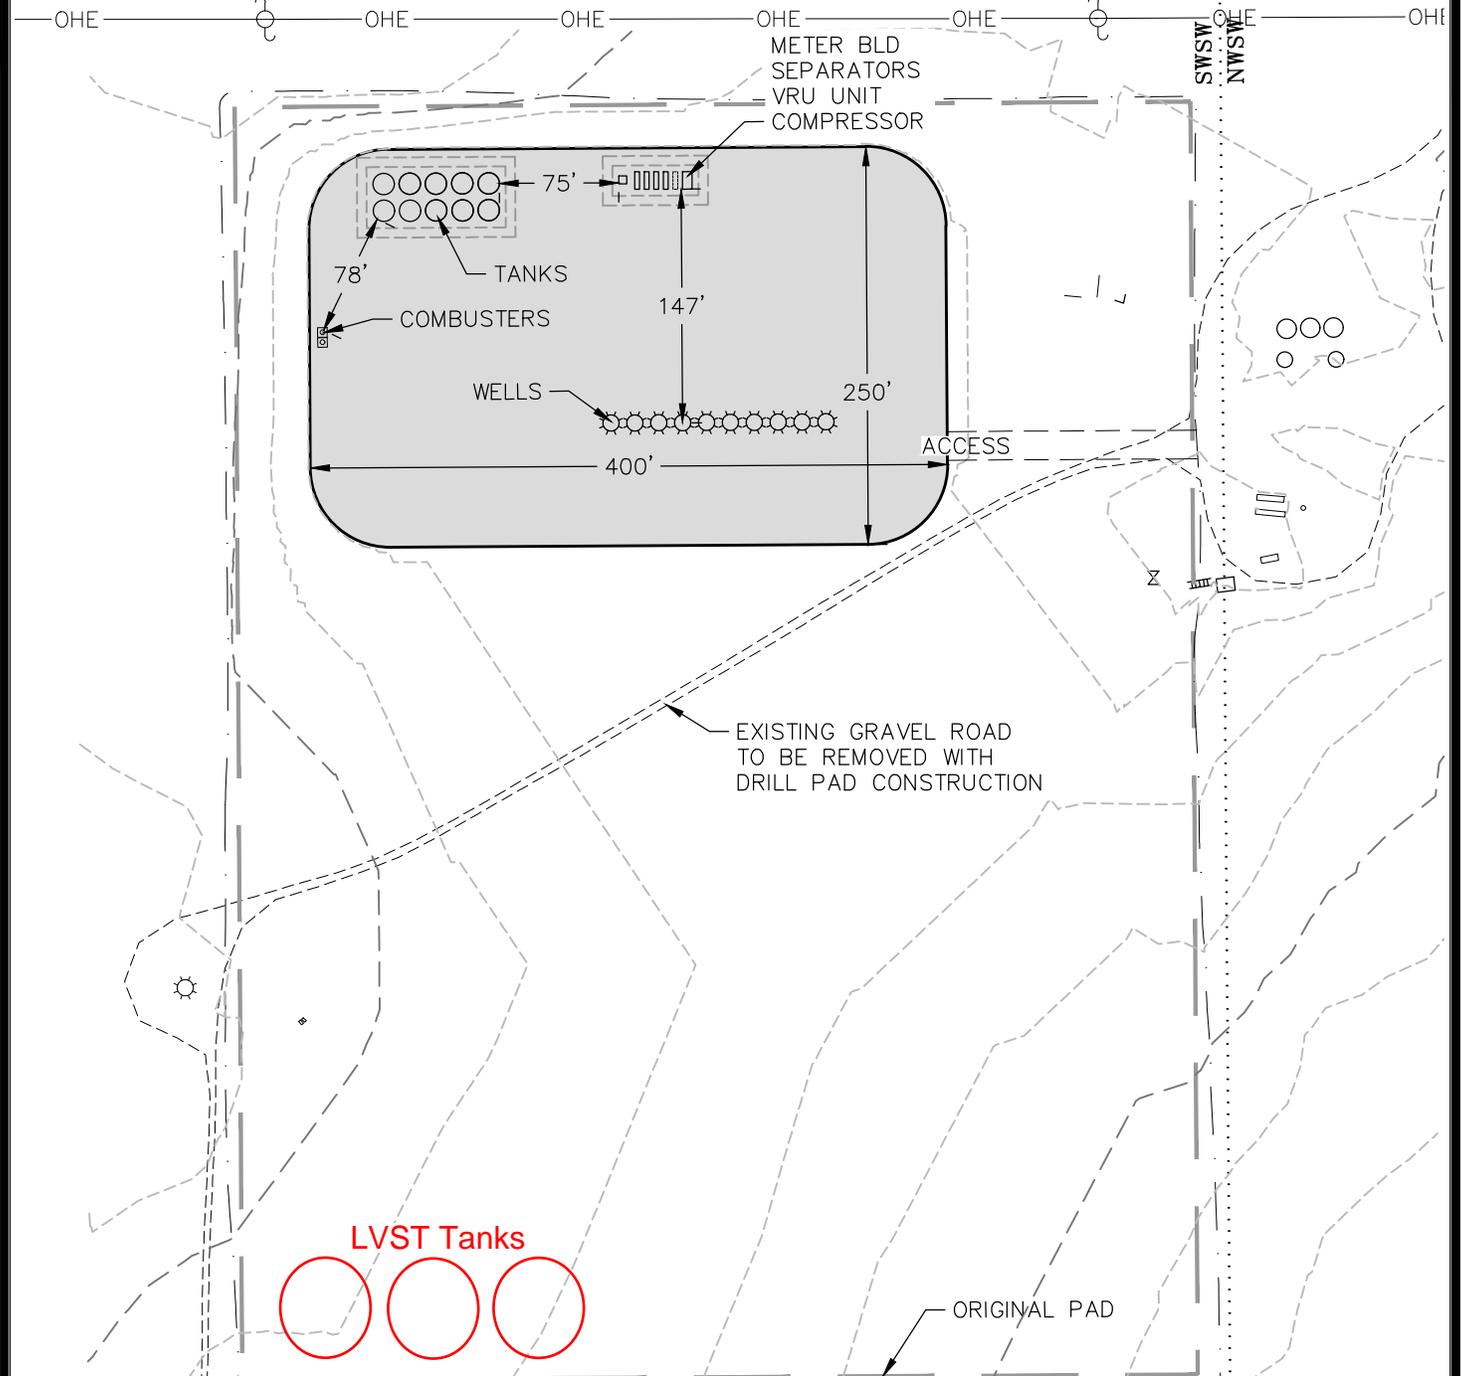

NOTES:

- 1) THIS IS A TYPICAL LAYOUT FOR THE PRODUCTION EQUIPMENT AND IS SUBJECT TO CHANGE DUE TO WELL PRODUCTION AND OPERATOR'S NEEDS.
- 2) PRODUCTION EQUIPMENT LAYOUT MUST MEET COGCC OFFSET REQUIREMENTS
- 3) TOTAL DISTURBED AREA INCLUDES TOPSOIL AND EXCESS MATERIAL STOCKPILE AREAS.
- 4) RECLAIMED SLOPES ARE VARIABLE.

TOTAL DISTURBED AREA = 12.26 ac.  
 RECLAIMED AREA = 10.01 ac.  
 UN-RECLAIMED AREA = 2.25 ac.  
 (SHADED AREA)



**ECLIPSE**  
 Surveying, Inc.

230 MAIN STREET, FORT MORGAN, CO 80701  
 (970) 370-2263

REV. DATE: ----  
 SCALE: 1" = 120'  
 DATE: 9/18/13  
 SHEET: 6 OF 8  
 PROJECT: 36-1S-66W S  
 DFT: TAB



**Bill Barrett Corporation**

STATE OF COLORADO 36-1S-66W SOUTH  
 RECLAIMED PAD & PRODUCTION  
 EQUIPMENT