


Well Name: LOUSTALET B15-09

VERTICAL - ORIGINAL HOLE, 11/11/2013 8:20:44 AM

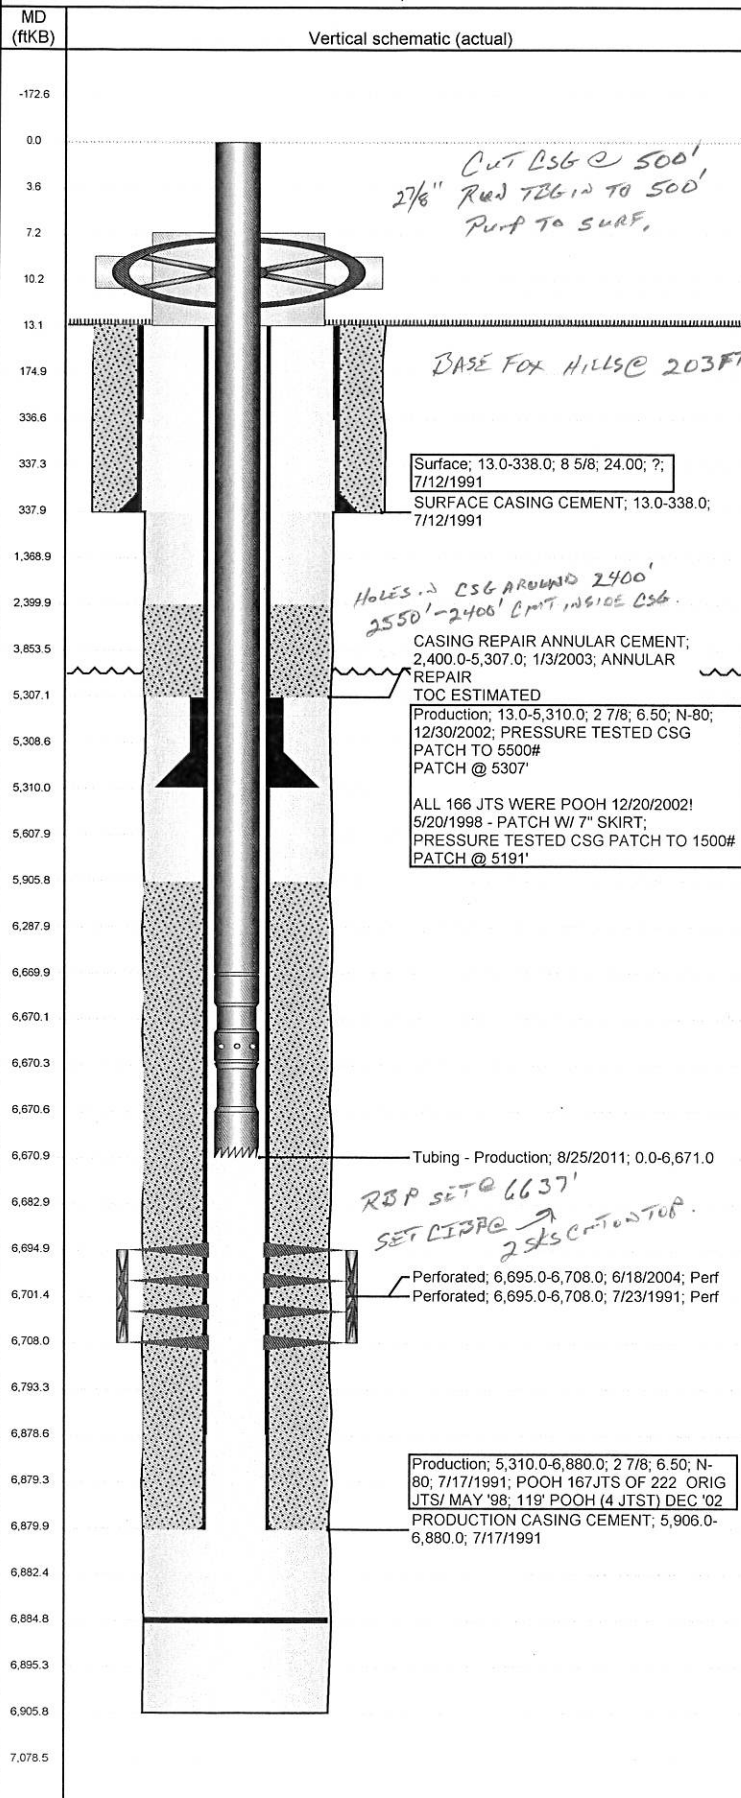

Stimulations & Treatments

Date	5/14/1999	Zone	CODELL, ORIGINAL HOLE	Primary Job Type	ACID TREATMENT
Technical Result		Tech Result Details		Tech Result Note	
Comment	WAS FRAC'D DWN CSG THAT WAS CUT & ALL POOH IN '02				
Date	6/28/2004	Zone	CODELL, ORIGINAL HOLE	Primary Job Type	RE-FRAC
Technical Result		Tech Result Details		Tech Result Note	
Comment					
Date	8/22/2011	Zone	CODELL, ORIGINAL HOLE	Primary Job Type	TRI-FRAC
Technical Result	Success	Tech Result Details	According to Plan	Tech Result Note	
Comment	(CODELL TF): HAD PROBLEMS WITH CLAYTREAT AND FLOWBACK LOADINGS SHOWING UP CORRECTLY. SHUT DOWN FOR 38 MINUTES TO FIGURE OUT THE CORRECT SETTINGS IN THE COMPUTER. JOB WENT WELL WITH NO OTHER ISSUES TO REPORT. POST JOB 5 MIN 3659				

Other In Hole

Run Date	Des	OD (in)	Top (ftKB)	Btm (ftKB)

Logs

Date	Type	Top (ftKB)	Btm (ftKB)
7/17/1991	COMPENSATED DENSITY	3,900.0	6,885.0
7/22/1991	CBL/CCL/GR	5,800.0	6,826.0