




Lat40°, Inc. 1635 Foxtrail Drive, Suite 325 Loveland, CO 970-776-3321

WELL LOCATION CERTIFICATE

THIS MAP DOES NOT REPRESENT A BOUNDARY SURVEY

SECTION: 26
TOWNSHIP: 5N
RANGE: 63W

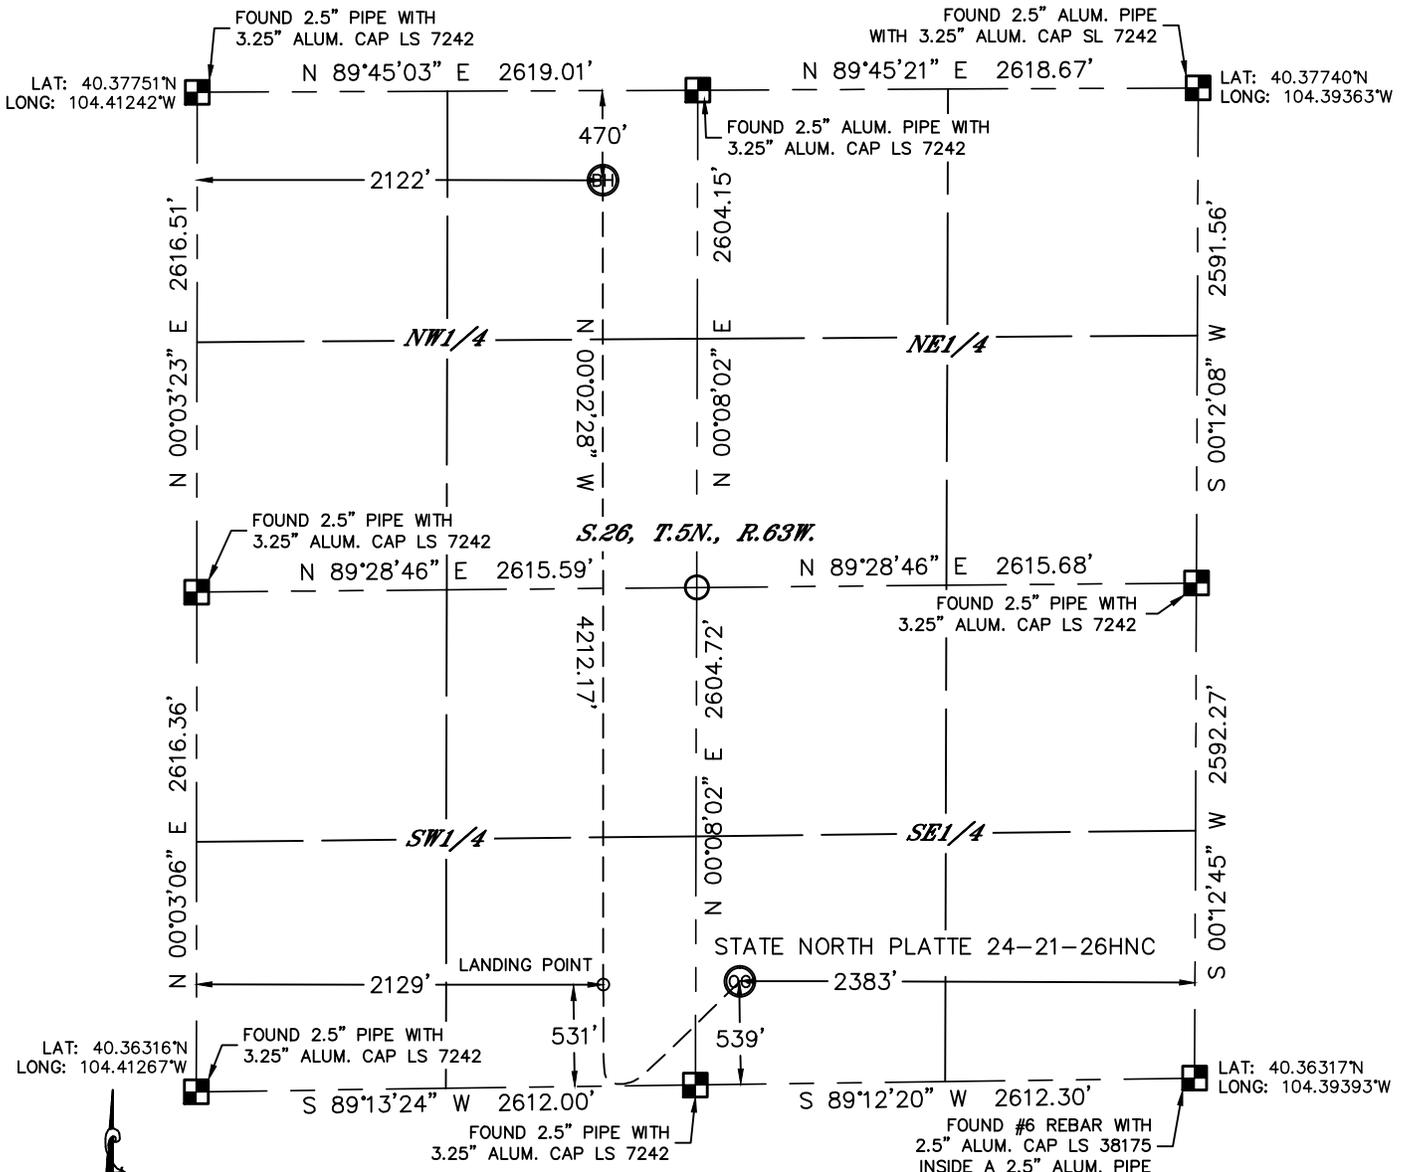

In accordance with a request from Michael Meagher with BONANZA CREEK ENERGY, INC. Lat40°, Inc. has determined the surface location of the STATE NORTH PLATTE 24-21-26HNC to be 539' from the SOUTH line and 2383' from the EAST line and the bottom hole to be 470' from the NORTH line and 2122' from the WEST line as measured at right angles from the section lines of Section 26, Township 5 North, Range 63 West of the Sixth Principal Meridian, County of Weld, State of Colorado.

I hereby state that this Well Location Certificate was prepared by me, or under my direct supervision, that the fieldwork was completed on 10/21/2013, for and on behalf of BONANZA CREEK ENERGY, INC. That this is not a Land Survey Plat or an Improvement Survey Plat, and that it is not to be relied upon for establishment of fence, building, or other future improvement lines.

NOTE:

- 1) Bearings shown are Grid Bearings of the Colorado State Plane Coordinate System, North Zone, North American Datum 1983/2007. The lineal dimensions as contained herein are based upon the "U.S. Survey Foot."
- 2) Ground elevations are based on an observed GPS elevation (NAVD 1988 DATUM).
- 3) IMPROVEMENTS: See LOCATION DRAWING for all visible improvements within 500' of disturbed area.
- 4) SURFACE USE: EXISTING PAD
- 5) INSTRUMENT OPERATOR: WYATT HALL

SURFACE LOCATION


LAT: 40.36464°N
LONG: 104.40244°W
PDOP: 1.8
ELEV: 4550'
1/4,1/4: SW1/4SE1/4
NEAREST PROPERTY LINE: 539' S

BOTTOM HOLE

LAT: 40.37618°N
LONG: 104.40483°W
1/4,1/4: NE1/4NW1/4

LANDING POINT

LAT: 40.36462°N
LONG: 104.40500°W
1/4,1/4: SE1/4SW1/4

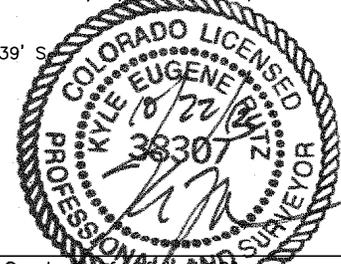

Kyle E. Rutz—On behalf of Lat40°, Inc.

Colorado Licensed Professional Land Surveyor No. 38307

DATE: rev10/21/2013
PROJECT#: 2012178

- LEGEND**
- = ALIQUOT MONUMENT AS DESCRIBED
 - = CALCULATED POSITION

NOTE
According to Colorado law, you must commence any legal action based upon any defect in this W.L.C. within three years after you discover such defect. In no event, may any action based upon any defect in this survey be commenced more than ten years after the date of the certificate shown hereon. (13-80-105 C.R.S.)

