

T7S, R94W, 6th P.M.

42.9'
SOUTH

N89°52'16"W - 2651.24' (Meas.)

S89°56'37"W
2660.41' (Meas.)

C.C. SW Cor. Sec. 31
1920 Brass Cap
0.9' High
Lat: 39.409969°
Long: 107.825939°

W.C. 1920 Brass Cap
1.0' High
Lat: 39.402600°
Long: 107.844742°

1920 Brass Cap
1.7' High
Lat: 39.402706°
Long: 107.835361°

1920 Brass Cap
1.3' High
Lat: 39.402717°
Long: 107.825950°

S19°10'14"E
2967.27'

2804'

R 94
W 93
W

(AS-DRILLED) TPR #132-36
Elev. Graded Ground = 9354'

1680'
(COMP.)

36

6733.32' (G.L.O.)

NOTE:
THERE ARE NO EXISTING IMPROVEMENTS
WITHIN 200' OF THE PROPOSED WELL
HEAD.

T7S
T8S

WEST - 5280.00' (G.L.O.)

PDOP = 2.0

SURFACE USE OF LOCATION IS
GRAZING, VEGETATION CONSISTS
MAINLY OF PINE TREE & NATIVE
GRASSES.

NAD 83 (AS-DRILLED SURFACE LOCATION)
LATITUDE = 39°23'42.06" (39.395017)
LONGITUDE = 107°49'54.87" (107.831908)
NAD 27 (AS-DRILLED SURFACE LOCATION)
LATITUDE = 39°23'42.13" (39.395036)
LONGITUDE = 107°49'52.63" (107.831286)

BLACK DIAMOND MINERALS, LLC

Well location, (AS-DRILLED) TPR #132-36, located
as shown in the SW 1/4 NE 1/4 of Section 36,
T7S, R94W, 6th P.M., Garfield County, Colorado.

BASIS OF ELEVATION


BENCH MARK LOCATED IN THE NE 1/4 OF SECTION 36,
T5S, R93W, 6th P.M. TAKEN FROM THE RIFLE QUADRANGLE,
COLORADO, GARFIELD COUNTY, 7.5 MINUTE SERIES
(TOPOGRAPHICAL MAP) PUBLISHED BY THE UNITED STATES
DEPARTMENT OF THE INTERIOR, GEOLOGICAL SURVEY. SAID
ELEVATION IS MARKED AS BEING 5546.19 FEET.

BASIS OF BEARINGS

BASIS OF BEARINGS IS A G.P.S. OBSERVATION.

LEGEND:

- └─┘ = 90° SYMBOL
- = PROPOSED WELL HEAD.
- ▲ = SECTION CORNERS LOCATED.
- △ = SECTION CORNERS
RE-ESTABLISHED.
(Not Set on Ground.)

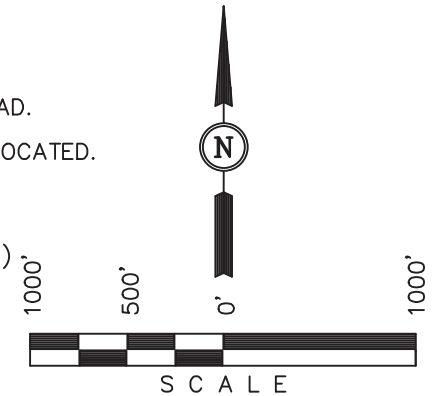

CERTIFICATE

THIS IS TO CERTIFY THAT THE ABOVE PLAT WAS PREPARED FROM
FIELD NOTES OF ACTUAL SURVEYS MADE BY ME OR UNDER MY
SUPERVISION AND THAT THE SAME ARE TRUE AND CORRECT TO THE
BEST OF MY KNOWLEDGE AND BELIEF.

REGISTERED LAND SURVEYOR
REGISTRATION NO. 17492
STATE OF COLORADO 01-06-13

UINTAH ENGINEERING & LAND SURVEYING
85 SOUTH 200 EAST - VERNAL, UTAH 84078
(435) 789-1017

SCALE 1" = 1000'	DATE SURVEYED: 10-31-13	DATE DRAWN: 11-05-13
PARTY B.B. B.B. T.B.	REFERENCES G.L.O. PLAT	
WEATHER COLD	FILE BLACK DIAMOND MINERALS, LLC	