


**KERR-MCGEE OIL AND GAS ONSHORE LP**

**KANZLER 6-1A  
SE NW 1 2N 67W -- --  
WELD,COLORADO  
11/18/2013**

**AREA: S1      ROUTE: S12    Spud: 04/08/2002    WINS No.: 74800    AFE/WO#: 2089568    API#: 0512320783**

**GL: 4826    KB: 4838    MTD: 7956    TVD: 7956    LOG MD:    PBMD: 7926    PBTVD: 7926**

**Directions:    WCR 24-1/2 AND WCR 23, EAST INTO DRIVEWAY 1/8 MILE TO LOCATION.**

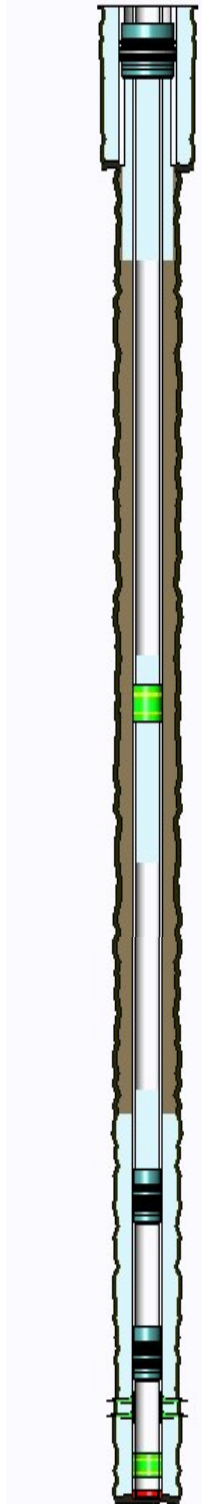

<u>HOLE SECTIONS</u>	<u>Size</u>	<u>Top</u>	<u>Btm</u>	<u>TD Date</u>				
SURFACE	12.25	12	681	04/08/2002				
PRODUCTION	7.88	681	7956	04/15/2002				
<u>TUBULARS</u>	<u>Tool Type</u>	<u>Joints</u>	<u>Size</u>	<u>Weight</u>	<u>Grade</u>	<u>Thread</u>	<u>Top D</u>	<u>Bottom D</u>
SURFACE CASING	Casing	20	8.63	24	J-55	STC	12	671
PRODUCTION CASING	Casing	179	4.50	11.6	I-80	LTC	12	7926
		1	4.50				7926	7927
	Casing	1	4.50	11.6	I-80	LTC	7927	7939
	Casing Guide Shoe	1	4.50				7939	7940
BRIDGE PLUG	Bridge Plug	1	4.50				7015	7028
BRIDGE PLUG	Bridge Plug	1	4.50				7700	7701
CAST IRON CEMENT RETAINER	Cement Retainer	1	4.50				4086	4087
BRIDGE PLUG	Bridge Plug	1	8.63				100	102
<u>CEMENT JOBS</u>	<u>Stage</u>	<u>Sacks</u>	<u>Cement Jobs</u>	<u>Top D</u>	<u>Btm D</u>	<u>cbl</u>		
SURFACE CASING	STAGE 1	485	NEAT	12	671	No		
PRODUCTION CASING	STAGE 1	250	G	6657	7940	Yes		
PRODUCTION CASING	ABANDONMENT PLUC	30	LEAD	6490	7015	No		
	ABANDONMENT PLUC	420	TAIL	3881	5000	No		
SURFACE CASING	ABANDONMENT PLUC	240	LEAD	111	11290	No		
<u>PERFORATIONS</u>	<u>Formation</u>	<u>Zone</u>	<u>Top</u>	<u>Btm</u>	<u>Date</u>	<u>Reason</u>	<u>Comments</u>	
	NIOBRARA		4040	4041	10/28/2013	CEMENT SQUEEZE		
	SUSSEX		5000	5001	10/28/2013	CEMENT SQUEEZE		
			7766	7830	04/16/2002		FORMATION: DAKOTA J/SD/	

**Comments:**